

49 SUNNYSIDE



Existing and Proposed Conditions
Residential Lots **Below 150 Mean Sea Level**

The following table should be placed on the cover sheet of the plan set in this format.
If something is inapplicable to your project please indicate "Not Applicable" or "N/A" in the appropriate box, do not leave cells blank.

	Existing	Proposed	Code
Zoning	R-1	R-1	
General Plan Designation	Single Family	Single Family	
Flood Zone	No	No	
Lot Area (Sq. Ft.)	8346 sf	8346sf	From Survey
LOT COVERAGE			
Lot coverage (sq. ft.) – footprint of all structures, porches, roof overhangs over 2 feet, and decks >36 inches above grade.	1601 sf	1460 sf	SACMC 10-3.412
Lot coverage %	19.2%	17.5%	35% max
FLOOR AREA			
Adjusted Floor Area (sq. ft.)			
First Floor	556.5	966.9	
Second Floor	1560.9	1410.3	
Other Floors	N/A	N/A	
Garage area over 400 sq. ft.	0	82.9	
Basement	0	N/A	
Crawl Space with concrete floor	0	0	
Attic with floor	0	0	
Areas with ceiling > 15 feet in height	0	0	
Accessory Structures	0	0	
Accessory Dwelling Unit(s)	0	0	
Total (sq. ft.)	2117.4	2460.1	
Adjusted Floor Area Ratio %	25.4%	29.4%	
Garage area	232.7	482.9	
SETBACKS			
Front	81'-6"	77'-5"	
Side	3'-2" - 3'-9"	5'-1"	
Side	9'-7" - 12'-9"	8'-2" - 11'-9"	
Rear	22'-5" - 34'-5"	39'-1"	
Street Side (if applicable)	N/A	N/A	
HEIGHT / STORIES			
Maximum height above average existing grade	31'- 6 1/2"	31'-1"	
Stories	2	2	
PARKING			
Onsite parking	1	2	
GRADING QUANTITIES			
Cut	0 sf	200 cu.yd.	
Fill	0 sf	-130 cu.yd.	
Total Combined	0 sf	70 cu.yd.	
Off-Haul	0 sf	70 cu.yd.	

PLAN CHECK - RESPONSE 1

DRAWN BY
AJM
CHECKED BY
AJM
FILE NAME
49Sunnyside_01.dwg
CLIENT
PHILLIPS/McCUNE
PROJECT
49 SUNNYSIDE AVE
JOB NUMBER
2022-001
ISSUANCE
PERMIT
DATE
JULY 01, 2022
SCALE

DRAWING NAME
COVER
SHEET

ABBREVIATIONS

&	And	GA	Gauge	SHTG	Sheathing
@	At	GALV	Galvanized	SIM	Similar
CL	Center Line	GL	Glass	SLNT	Sealant
⌀	Diameter	GND	Ground	SOG	Slab on Grade
#	Pound or Number	GWB	Gypsum Wall Board	SP	Stand Pipe
%	Percent	GYP	Gypsum	SPEC	Specifications
AB	Anchor Bolt	H	High	SQ	Square
ABV	Above	HB	Hose Bibb	STC	Sound Transmission Class
ACT	Acoustic Tile	HC	Hollow Core	SSTL	Stainless Steel
ADA	Americans w/ Disabilities Act	HCV	Hollow Core Wood	ST	Slate Tile
ADJ	Adjustable	HD	Head/Heavy Duty	STD	Standard
AFF	Above Finish Floor	HDR	Header	STL	Steel
ALT	Alternate	HM	Hollow Metal	STOR	Storage
ALUM	Aluminum	HORIZ	Horizontal	STRL	Structural
APPROX	Approximate	HR	Hour	SUSP	Suspension
ARCH	Architectural	HT	Height	SYM	Symmetrical
AVG	Average			T	Top/Tread
BD	Board	INCL	Include(d)(ing)	TEL	Telephone
BEL	Below	INSUL	Insulation	TEMP	Temporary
BITUM	Bituminous	INT	Interior		Temperature
BLDG	Building	INTM	Intermediate		Tempered
BM	Beam	IRR	Irrigation	T&G	Tough & Groove
BO	Bottom of	JAN	Janitor	THK	Thickness
BOT	Bottom	JT	Joint	THR	Threshold
BSMT	Basement			TO	Top of
BTWN	Between	L	Long/Length	TOC	Top of Concrete
CAB	Cabinet	LAM	Laminate	TOS	Top of Steel
CEM	Cement	LAV	Lavatory	TOW	Top of Wall
CER	Ceramic	LD	Landscape Drain	TOP	Top of Parapet
CIP	Cast-in-Place	LH	Left Hand		Top of Pavement
CJ	Control Joint	LIN	Lineal	TRTD	Treated
CLNG	Ceiling	LOCN	Location	TV	Telephone
CLOS	Closet	LT	Light	TYP	Typical
CLR	Clear	MAS	Masonry	UBC	Uniform Building Code
CMU	Concrete Masonry Unit	MEN	Men's Restroom	UL	Underwriter's Laboratory
COL	Column	MAX	Maximum	UNO	Unless Noted Otherwise
CONC	Concrete	MECH	Mechanical	VCT	Vinyl Composition Tile
COND	Condition	MEMB	Membrane	VENT	Ventilation
CONN	Connection	MFR	Manufacturer	VERT	Vertical
CONSTR	Construction	MIN	Minimum	VEST	Vestibule
CONT	Continuous	MTD	Mounted	VOL	Volume
CONTR	Contractor	MTL	Metal	VTR	Vent Through Roof
CORR	Corridor	N	North	W	West
CPT	Carpet	NA	Not Applicable	WOMEN	Women's Restroom
CT	Ceramic Tile	NIC	Not in Contract	W/	With
CNTR	Counter	NO	Number	WB	Washbasin
CTR	Center	NOM	Nominal	WC	Water Closet
DBL	Double	NTS	Not to Scale	WD	Wood
DET	Detail			WDW	Window
DIA	Diameter	OA	Overall	WH	Wall Hung
DIAG	Diagonal	OC	On Center	W/O	Without
DIM	Dimension	OFD	Overflow Drain	WP	Waterproof(ing)
DN	Down	OH	Opposite Hand/Overhead	WR	Water Repellant
DR	Door	OPNG	Opening	WT	Weight
DS	Downspout	OPP	Opposite	WWF	Welded Wire Fabric
DWG	Drawing	PKG	Parking	YD	Yard
(E)	Existing	PL	Plate		
E	East	PL	Property Line		
EA	Each	PLAM	Plastic Laminate		
EL	Elevation	PLAS	Plaster		
ELEC	Electrical	PLYWD	Plywood		
ELEV	Elevator	PNL	Panel		
EMER	Emergency	PNT	Paint(ed)		
EQ	Equal	POB	Point of Beginning		
EQPT	Equipment	PR	Pair		
EXIST	Existing	PT	Point		
EXT	Exterior	PTD	Painted		
EXTR	Extruded	PTN	Partition		
FD	Floor Drain	R	Riser/Radius		
FE	Fire Extinguisher	RA	Relieving Angle		
FEC	FE Cabinet	RCP	Reflected Ceiling Plan		
FHC	Fire Hose Cabinet	RD	Roof Drain		
FIN	Finish	REF	Reference		
FLR	Floor	REFR	Refrigerator		
FLASH	Flashing	REINF	Reinforced		
FO	Face of	REQD	Required		
FOC	Face of Concrete	REV	Reverse/Revised		
FOF	Face of Finish	RF	Roof		
FOIC	Furnished by Owner, Installed by Contractor	RFG	Roofing		
		RH	Right Hand		
		RM	Room		
		RO	Rough Opening		
FOIO	Furnished by Owner, Installed by Owner	S	South		
		SC	Solid Core		
FOS	Face of Stud	SCHED	Schedule		
FP	Floor Plan	SCW	Solid Core Wood		
FRT	Fire Retardant	SECT	Section		
FT	Foot or Feet	SF	Square Feet		
FTG	Footing	SH	Shelf		
		SHT	Sheet		

GRAPHIC SYMBOLS

DETAIL	
Detail Number	
Sheet Number	
DETAIL	
Detail Number	
Sheet Number	
BUILDING SECTION	
Section Number	
Sheet Number	
BUILDING ELEVATION	
Elevation Number	
Sheet Number	
INTERIOR ELEVATION	
Elevation Number	
Sheet Number	
ROOM NUMBER	
DOOR NUMBER	
WINDOW NUMBER	
CONTROL ELEVATION	
SPOT ELEVATION	
HIDDEN / OVERHEAD	
REVISION	
REVISION INDICATOR	

MATERIALS LEGEND

	EARTH		BATT INSULATION
	GRAVEL/ CRUSHED STONE		CONTINUOUS WOOD FRAMING
	MASONRY		WOOD BLOCKING
	CONCRETE		STEEL
	GROUT		ALUMINUM
	RIGID INSULATION		

COMPLIANCE

THE PROJECT COMPLIES WITH THE FOLLOWING 2019 TOWN OF SAN ANSELMO BUILDING REACH CODES (CALGREEN) REQUIREMENTS:

A) AUTOMATIC IRRIGATION SYSTEMS CONTROLLERS INSTALLED AT THE TIME OF INSPECTION SHALL BE WEATHER-BASED (4.304).

B) PROTECT ANNULAR SPACES AROUND PIPES, ELECTRIC CABLES, CONDUITS AT EXTERIOR WALLS AGAINST THE PASSAGE OF RODENTS (4.406.1).

C) COVER DUCT OPENINGS AND OTHER RELATED AIR DISTRIBUTION COMPONENT OPENINGS DURING CONSTRUCTION (4.504.1)

D) ADHESIVES, SEALANTS AND OTHER COATINGS SHALL BE COMPLIANT WITH VOE AND OTHER TOXIC COMPOUND LIMITS (4.504.2.1).

E) PAINTS, STAINS AND OTHER COATINGS SHALL BE COMPLIANT WITH VOE LIMITS (4.504.2.2).

F) AEROSOL PAINTS AND COATINGS SHALL BE COMPLIANT WITH PRODUCT WEIGHTED MIR LIMITS FOR ROC AND OTHER TOXIC COMPOUNDS (4.504.2.3)

G) CARPET AND CARPET SYSTEMS SHALL BE COMPLIANT WITH VOE LIMITS (4.504.3).

H) MINIMUM 90% OF FLOOR AREA RECEIVING RESILIENT FLOORING SHALL COMPLY WITH SECTION 4.504.4.

I) PARTICLE BOARD, MEDIUM DENSITY FIBERBOARD (MDF) AND HARDWOOD PLYWOOD USED IN INTERIOR FINISH SYSTEMS SHALL COMPLY WITH LOW FORMALDEHYDE EMISSION STANDARDS (4.504.5)

J) DOCUMENTATION OF COMPLIANT VOC FINISH MATERIALS WILL BE PROVIDED.

K) THERMAL INSULATION SHALL BE WITHIN VOC LIMITS.

J) DOCUMENTATION OF COMPLIANT VOC FINISH MATERIALS WILL BE PROVIDED.

****) INSTALL CAPILLARY BREAK AND VAPOR RETARDER AT SLAB ON GRADE FOUNDATIONS (4.504.4).

L) CHECK MOISTURE CONTENT OF BUILDING MATERIALS USED IN WALL AND FLOOR FRAMING BEFORE ENCLOSURE (4.505.3)

M) PROVIDE A COPY OF THE MAINTENANCE AND OPERATION MANUAL TO THE BUILDING OCCUPANT OR OWNER ADDRESSING ITEMS 1-10 IN SECTION 4.410.1.. THE EXISTING DWELLING COMPLIES WITH THE REQUIREMENTS FOR SMOKE DETECTORS AND CARBON MONOXIDE DETECTORS. SMOKE DETECTORS ARE LOCATED IN ALL BEDROOMS AND IN THE IMMEDIATE VICINITY OF EACH BEDROOM. CARBON MONOXIDE DETECTORS ARE INSTALLED IN AREAS LEADING TO BEDROOMS.

N) OUTSIDE POTABLE WATER USE IN LANDSCAPE AREAS: RESIDENTIAL DEVELOPMENT SHALL COMPLY WITH A LOCAL WATER EFFICIENT LANDSCAPE ORDINANCE OR THE CURRENT CALIFORNIA DEPARTMENT OF WATER RESOURCES' MODEL WATER EFFICIENT LANDSCAPE ORDINANCE (MWELO), WHICHEVER IS MORE STRINGENT (4.304.1).

O) PLUMBING FIXTURES, INSTALLED PER CALIFORNIA PLUMBING CODE WILL COMPLY WITH PRESCRIPTIVE REQUIREMENTS PER 4.303.1.1 THRU 4.303.1.4.4.

P) PER "ZERO WASTE MARIN", 65% OF NON-HAZARDOUS CONSTRUCTION AND DEMOLITION WASTE WILL BE RECYCLED OR SALVAGED.

Q) EACH BATHROOM PROVIDED WITH THE FOLLOWING: ENERGY STAR FANS DUCTED TO THE OUTSIDE; FANS CONTROLLED BY HUMIDITY CONTROL; HUMIDITY CONTROLS CAPABLE OF ADJUSTMENT BETWEEN A RELATIVE HUMIDITY RANGE OF BETWEEN 50-80 PERCENT.

SHEET INDEX

ARCHITECTURAL	
A0.000	GENERAL INFORMATION & SHEET INDEX
A0.010	CALGREEN - MANDATORY MEASURES - SHEET 1
A0.020	CALGREEN - MANDATORY MEASURES - SHEET 2
A0.030	LOW-RISE MANDATORY MEASURES SUMMARY
A0.100	SITE SURVEY
A0.110	SITE PHOTOS
A1.000	SITE PLAN - DEMOLITION
A1.010	SITE PLAN - PROPOSED
A1.020	STORMWATER POLLUTION BEST MANAGEMENT PRACTICES
A1.030	SITE PLANS - DRAINAGE
A1.100	FLOOR PLAN - BASEMENT/GARAGE (EXISTING)
A1.110	FLOOR PLAN - BASEMENT/GARAGE (NEW)
A1.200	FLOOR PLAN - LEVEL ONE (EXISTING)
A1.210	FLOOR PLAN - LEVEL ONE (NEW)
A2.000	EAST ELEVATIONS
A2.010	SOUTH ELEVATIONS
A2.020	WEST ELEVATIONS
A2.030	NORTH ELEVATIONS
A3.000	SITE & BUILDING SECTIONS
A3.010	SITE & BUILDING SECTIONS
A9.000	ISOMETRIC VIEWS - EXCAVATION & GRADING

PROJECT DESCRIPTION


CLEARING/GRUBBING OF REAR YARD AND DEMOLITION OF EXISTING GARAGE/BASEMENT & CRAWLSPACE. CONSTRUCTION OF A NEW CONCRETE FOUNDATION THAT CONTAINS THE FOLLOWING: 2-CAR GARAGE, 1 NEW BEDROOM, 1 BATHROOM, LAUNDRY, STORAGE, MUDROOM, & PROJECT ROOM. A DECK, SITE WALLS, RETAINING WALLS AND PLANTERS ARE ALSO PART OF THE PROJECT SCOPE.

NO CONSTRUCTION WILL OCCUR WITHIN THE DRIP LINE OF TREES WITH TRUNK DIAMETERS OF 22" OR GREATER.

DEFERRED PERMITS

- 1) FIRE SPRINKLER SYSTEMS
- 2) DEFERRED FIRE PERMIT - W/ VEGETATIVE MANAGEMENT PLAN (VMP) SUBMITTAL

VICINITY MAP

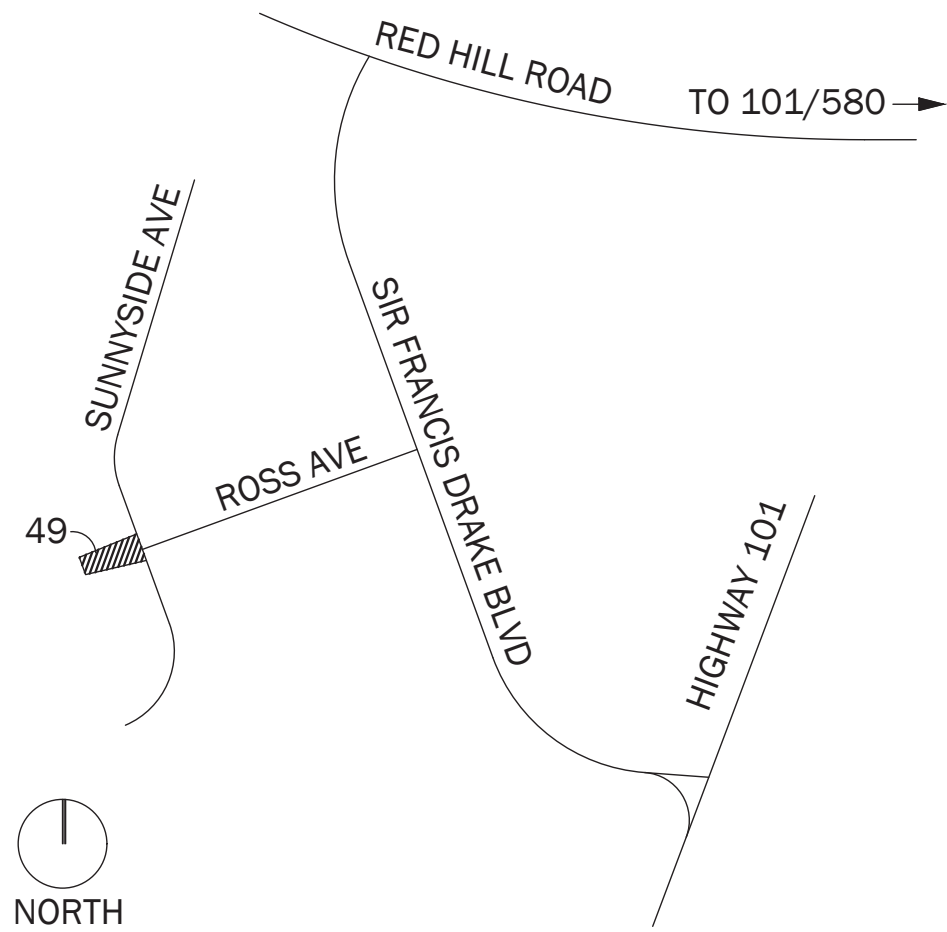

PROJECT INFORMATION

APPLICABLE CODES:	
2019 EDITION OF THE CALIFORNIA RESIDENTIAL CODE	
2019 EDITION OF THE CALIFORNIA MECHANICAL CODE	
2019 EDITION OF THE CALIFORNIA ELECTRICAL CODE	
2019 EDITION OF THE CALIFORNIA PLUMBING CODE	
2019 EDITION OF THE CALIFORNIA ENERGY CODE	
2019 EDITION OF THE CALIFORNIA GREEN BUILDING STANDARDS CODE	
SAN ANSELMO, CALIFORNIA MUNICIPAL CODE (SACMC)	
BUILDING CLASSIFICATION:	TYPE V-B
OCCUPANCY:	R-3, U
ZONING:	R-1 (BELOW 150')
WUI:	YES. PROJECT TO MEET REQUIREMENTS OF SACMC 9-1.214, CRC 337.2 & CBC 701A.3
ADDRESS:	49 SUNNYSIDE AVENUE SAN ANSELMO, CA 94960
APN:	007-263-24
OWNERS:	KATHRYN PHILLIPS & ANDREW McCUNE
CONTACT:	ANDREW McCUNE 206.850.8500 andrew@andrewmccune.com


PROJECT DATA

LOT AREA:	8346 SF	
MAX LOT COVERAGE (35%)	2921 SF	10-3.412 (SACMC)
EXISTING LOT COVERAGE (19%)	1601 SF	
PROPOSED LOT COVERAGE (18%)	1479 SF	
FAR (35%):	2921 SF	10-3.412 (SACMC)
GARAGE EXEMPTION:	400 SF	10-3.412 (SACMC)
AREA BONUS:	325 SF	TABLE 4F, 10-3.412 (SACMC)
MAX ALLOWED FLOOR AREA:	3646 SF	TABLE 4F, 10-3.412 (SACMC)
MAX STORIES:	2	TABLE 4A, 10-3.402 (SACMC)
MAX HEIGHT:	30'	TABLE 4A, 10-3.402 (SACMC)
MIN FRONT SETBACK:	20'	TABLE 4A, 10-3.402 (SACMC)
MIN REAR SETBACK:	20'	TABLE 4A, 10-3.402 (SACMC)
MIN SIDE SETBACKS:	8'	TABLE 4A, 10-3.402 (SACMC)

ANDREW
McCUNE
ARCHITECT

PO Box 78115
San Francisco, CA 94107
T (206) 850 8500
www.andrewmccune.com

49 SUNNYSIDE AVE
SAN ANSELMO, CA 94960

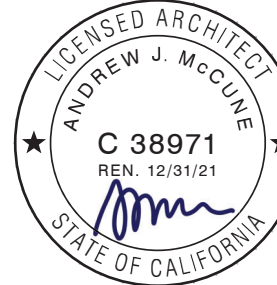

PLAN CHECK - RESPONSE 1

DRAWN BY
AJM
CHECKED BY
AJM
FILE NAME
49Sunnyside_01.dwg
CLIENT
PHILLIPS/McCUNE
PROJECT
49 SUNNYSIDE AVE
JOB NUMBER
2022-001
ISSUANCE
PERMIT
DATE
JULY 01, 2022
SCALE

DRAWING NAME
GENERAL
INFORMATION
& SHEET INDEX

SHEET NUMBER
A0.000

DISCLAIMER: THIS DOCUMENT IS PROVIDED AND INTENDED TO BE USED AS A MEANS TO INDICATE AREAS OF COMPLIANCE WITH THE 2016 CALIFORNIA GREEN BUILDING STANDARDS (CALGREEN) CODE. DUE TO THE VARIABLES BETWEEN BUILDING DEPARTMENT JURISDICTIONS, THIS CHECKLIST IS TO BE USED ON AN INDIVIDUAL PROJECT BASIS AND MAY BE MODIFIED BY THE END USER TO MEET THOSE INDIVIDUAL NEEDS. THE END USER ASSUMES ALL RESPONSIBILITY ASSOCIATED WITH THE USE OF THIS DOCUMENT, INCLUDING VERIFICATION WITH THE FULL CODE.



2019 Low-Rise Residential Mandatory Measures Summary

NOTE: Low-rise residential buildings subject to the Energy Standards must comply with all applicable mandatory measures, regardless of the compliance approach used. Review the respective section for more information. *Exceptions may apply. (01/2020)

Building Envelope Measures:	
§ 110.6(a):	Air Leakage. Manufactured fenestration, exterior doors, and exterior pet doors must limit air leakage to 0.3 CFM per square foot or less when tested per NFRC-400, ASTM E283 or AAMA/WDMA/CSA 1011.S 2/A440-2011.*
§ 110.6(a)5:	Labeling. Fenestration products and exterior doors must have a label meeting the requirements of § 101-11(a).
§ 110.6(b):	Field fabricated exterior doors and fenestration products must use U-factors and solar heat gain coefficient (SHGC) values from Tables 110.6-A, 110.6-B, or JA4.5 for exterior doors. They must be caulked and/or weather-stripped.*
§ 110.7:	Air Leakage. All joints, penetrations, and other openings in the building envelope that are potential sources of air leakage must be caulked, gasketed, or weather stripped.
§ 110.8(a):	Insulation Certification by Manufacturers. Insulation must be certified by the Department of Consumer Affairs, Bureau of Household Goods and Services (BHGS).
§ 110.8(g):	Insulation Requirements for Heated Slab Floors. Heated slab floors must be insulated per the requirements of § 110.8(g).
§ 110.8(h):	Roofing Products Solar Reflectance and Thermal Emittance. The thermal emittance and aged solar reflectance values of the roofing material must meet the requirements of § 110.8(h) and be labeled per §10-113 when the installation of a cool roof is specified on the CF-IR.
§ 110.8(i):	Radiant Barrier. When required, radiant barriers must have an emittance of 0.05 or less and be certified to the Department of Consumer Affairs.
§ 110.8(j):	Ceiling and Rafter Roof Insulation. Minimum R-22 insulation in wood-frame ceiling, or the weighted average U-factor must not exceed 0.043. Minimum R-19 or weighted average U-factor of 0.054 or less in a rafter roof alteration. All access doors must have permanently attached insulation using adhesive or mechanical fasteners. The attic access must be gasketed to prevent air leakage. Insulation must be installed in direct contact with a continuous roof or ceiling which is sealed to limit infiltration and exfiltration as specified in § 110.7, including but not limited to placing insulation either above or below the roof deck or on top of a drywall ceiling.*
§ 150.0(b):	Loose-fill Insulation. Loose fill insulation must meet the manufacturer's required density for the labeled R-value.
§ 150.0(c):	Wall Insulation. Minimum R-13 insulation in 2x4 inch wood framing wall or have a U-factor of 0.102 or less, or R-20 in 2x6 inch wood framing or have a U-factor of 0.071 or less. Opaque non-framed assemblies must have an overall assembly U-factor not exceeding 0.102. Masonry walls must meet Tables 150.1-A or B.*
§ 150.0(d):	Raised-floor Insulation. Minimum R-19 insulation in raised wood framed floor or 0.037 maximum U-factor.*
§ 150.0(f):	Slab Edge Insulation. Slab edge insulation must meet all of the following: have a water absorption rate, for the insulation material alone without facings, no greater than 0.3 percent; have a water vapor permeance no greater than 2.0 perm per inch; be protected from physical damage and UV light deterioration; and, when installed as part of a heated slab floor, meet the requirements of § 110.8(g).
§ 150.0(g)1:	Vapor Retarder. In climate zones 1 through 16, the earth floor of unvented crawl space must be covered with a Class I or Class II vapor retarder. This requirement also applies to controlled ventilation crawl space for buildings complying with the exception to § 150.0(d).
§ 150.0(g)2:	Vapor Retarder. In climate zones 14 and 16, a Class I or Class II vapor retarder must be installed on the conditioned space side of all insulation in all exterior walls, vented attics, and unvented attics with air-permeable insulation.
§ 150.0(q):	Fenestration Products. Fenestration, including skylights, separating conditioned space from unconditioned space or outdoors must have a maximum U-factor of 0.58; or the weighted average U-factor of all fenestration must not exceed 0.58.*
Fireplaces, Decorative Gas Appliances, and Gas Log Measures:	
§ 110.5(e):	Pilot Light. Continuously burning pilot lights are not allowed for indoor and outdoor fireplaces.
§ 150.0(e)1:	Closable Doors. Masonry or factory-built fireplaces must have a closable metal or glass door covering the entire opening of the firebox.
§ 150.0(e)2:	Combustion Intake. Masonry or factory-built fireplaces must have a combustion outside air intake, which is at least six square inches in area and is equipped with a readily accessible, operable, and light-lifting damper or combustion-air control device.*
§ 150.0(e)3:	Flue Damper. Masonry or factory-built fireplaces must have a flue damper with a readily accessible control.*
Space Conditioning, Water Heating, and Plumbing System Measures:	
§ 110.0-§ 110.3:	Certification. Heating, ventilation and air conditioning (HVAC) equipment, water heaters, showerheads, faucets, and all other regulated appliances must be certified by the manufacturer to the California Energy Commission.
§ 110.2(a):	HVAC Efficiency. Equipment must meet the applicable efficiency requirements in Table 110.2-A through Table 110.2-C.*
§ 110.2(b):	Controls for Heat Pumps with Supplementary Electric Resistance Heaters. Heat pumps with supplementary electric resistance heaters must have controls that prevent supplementary heater operation when the heating load can be met by the heat pump alone; and in which the cut-on temperature for compression heating is higher than the cut-on temperature for supplementary heating, and the cut-off temperature for compression heating is higher than the cut-off temperature for supplementary heating.*
§ 110.2(c):	Thermostats. All heating or cooling systems not controlled by a central energy management control system (EMCS) must have a setback thermostat.*
§ 110.3(c)4:	Water Heating Recirculation Loops Serving Multiple Dwelling Units. Water heating recirculation loops serving multiple dwelling units must meet the air release valve, backflow prevention, pump priming, pump isolation valve, and recirculation loop connection requirements of § 110.3(c)4.
§ 110.3(c)6:	Isolation Valves. Instantaneous water heaters with an input rating greater than 6.6 kBtu per hour (2 kW) must have isolation valves with hose bibbs or other fittings on both cold and hot water lines to allow for flushing the water heater when the valves are closed.
§ 110.5:	Pilot Lights. Continuously burning pilot lights are prohibited for natural gas, fan-type central furnaces; household cooking appliances (except appliances without an electrical supply voltage connection with pilot lights that consume less than 150 Btu per hour); and pool and spa heaters.*
§ 150.0(h)1:	Building Cooling and Heating Loads. Heating and/or cooling loads are calculated in accordance with the ASHRAE Handbook, Equipment Volume, Applications Volume, and Fundamentals Volume; the SMACNA Residential Comfort System Installation Standards Manual; or the ACCA Manual J using design conditions specified in § 150.0(h)2.




2019 Low-Rise Residential Mandatory Measures Summary


Requirements for Ventilation and Indoor Air Quality:	
§ 150.0(a):	Requirements for Ventilation and Indoor Air Quality. All dwelling units must meet the requirements of ASHRAE Standard 62.2, Ventilation and Acceptable Indoor Air Quality in Residential Buildings subject to the amendments specified in § 150.0(a)1.
§ 150.0(a)1C:	Single Family Detached Dwelling Units. Single family detached dwelling units, and attached dwelling units not sharing ceilings or floors with other dwelling units, occupiable spaces, public garages, or commercial spaces must have mechanical ventilation airflow provided at rates determined by ASHRAE 62.2 Sections 4.1.1 and 4.1.2 and as specified in § 150.0(a)1C.
§ 150.0(a)1E:	Multifamily Attached Dwelling Units. Multifamily attached dwelling units must have mechanical ventilation airflow provided at rates in accordance with Equation 150.0-B and must be either a balanced system or continuous supply or continuous exhaust system. If a balanced system is not used, all units in the building must use the same system type and the dwelling-unit envelope leakage must be ≤ 0.3 CFM at 50 Pa (0.2 inch water) per square foot of dwelling unit envelope surface area and verified in accordance with Reference Residential Appendix RA3.8.
§ 150.0(a)1F:	Multifamily Building Central Ventilation Systems. Central ventilation systems that serve multiple dwelling units must be balanced to provide ventilation airflow for each dwelling unit served at a rate equal to or greater than the rate specified by Equation 150.0-B. All unit airflows must be within 20 percent of the unit with the lowest airflow rate as it relates to the individual unit's minimum required airflow rate needed for compliance.
§ 150.0(a)1G:	Kitchen Range Hoods. Kitchen range hoods must be rated for sound in accordance with Section 7.2 of ASHRAE 62.2.
§ 150.0(a)2:	Field Verification and Diagnostic Testing. Dwelling unit ventilation airflow must be verified in accordance with Reference Residential Appendix RA3.7. A kitchen range hood must be verified in accordance with Reference Residential Appendix RA3.7.4.3 to confirm it is rated by HVI to comply with the airflow rates and sound requirements as specified in Section 5 and 7.2 of ASHRAE 62.2.
Pool and Spa Systems and Equipment Measures:	
§ 110.4(a):	Certification by Manufacturers. Any pool or spa heating system or equipment must be certified to have all of the following: a thermal efficiency that complies with the Appliance Efficiency Regulations; an on-off switch mounted outside of the heater that allows shutting off the heater without adjusting the thermostat setting; a permanent weatherproof plate or card with operating instructions; and must not use electric resistance heating.*
§ 110.4(b)1:	Piping. Any pool or spa heating system or equipment must be installed with at least 36 inches of pipe between the filter and the heater, or dedicated suction and return lines, or built-in or built-up connections to allow for future solar heating.*
§ 110.4(b)2:	Covers. Outdoor pools or spas that have a heat pump or gas heater must have a cover.
§ 110.4(b)3:	Directional Inlets and Time Switches for Pools. Pools must have directional inlets that adequately mix the pool water, and a time switch that will allow all pumps to be set or programmed to run only during off-peak electric demand periods.
§ 110.5:	Pilot Light. Natural gas pool and spa heaters must not have a continuously burning pilot light.*
§ 150.0(p):	Pool Systems and Equipment Installation. Residential pool systems or equipment must meet the specified requirements for pump sizing, flow rate, piping, filters, and valves.*
Lighting Measures:	
§ 110.9:	Lighting Controls and Components. All lighting control devices and systems, ballasts, and luminaires must meet the applicable requirements of § 110.9.*
§ 150.0(k)1A:	Luminaire Efficacy. All installed luminaires must meet the requirements in Table 150.0-A.
§ 150.0(k)1B:	Blank Electrical Boxes. The number of electrical boxes that are more than five feet above the finished floor and do not contain a luminaire or other device must be no greater than the number of bedrooms. These electrical boxes must be served by a dimmer, vacancy sensor control, or fan speed control.
§ 150.0(k)1C:	Recessed Downlight Luminaires in Ceilings. Luminaires recessed into ceilings must meet all of the requirements for: insulation contact (IC) labeling; and area and/or less; maintain and socket and light source as described in § 150.0(k)1C.*
§ 150.0(k)1D:	Electronic Ballasts for Fluorescent Lamps. Ballasts for fluorescent lamps rated 13 watts or greater must be electronic and must have an output frequency no less than 20 kHz.*
§ 150.0(k)1E:	Night Lights, Step Lights, and Path Lights. Night lights, step lights and path lights are not required to comply with Table 150.0-A or be controlled by vacancy sensors provided they are rated to consume no more than 5 watts of power and emit no more than 150 lumens.
§ 150.0(k)1F:	Lighting Integral to Exhaust Fans. Lighting integral to exhaust fans (except when installed by the manufacturer in kitchen exhaust hoods) must meet the applicable requirements of § 150.0(k)1F.*
§ 150.0(k)1G:	Screw based luminaires. Screw based luminaires must contain lamps that comply with Reference Joint Appendix JA8.*
§ 150.0(k)1H:	Light Sources in Enclosed or Recessed Luminaires. Lamps and other separable light sources that are not compliant with the JA8 elevated temperature requirements, including marking requirements, must not be installed in enclosed or recessed luminaires.
§ 150.0(k)1I:	Light Sources in Drawers, Cabinets, and Linen Closets. Light sources internal to drawers, cabinetry or linen closets are not required to comply with Table 150.0-A or be controlled by vacancy sensors provided that they are rated to consume no more than 5 watts of power, emit no more than 150 lumens, and are equipped with controls that automatically turn the lighting off when the drawer, cabinet or linen closet is closed.
§ 150.0(k)2A:	Interior Switches and Controls. All forward phase cut dimmers used with LED light sources must comply with NEMA SSL 7A.
§ 150.0(k)2B:	Interior Switches and Controls. Exhaust fans must be controlled separately from lighting systems.*
§ 150.0(k)2C:	Interior Switches and Controls. Lighting must have readily accessible wall-mounted controls that allow the lighting to be manually turned ON and OFF.*
§ 150.0(k)2D:	Interior Switches and Controls. Controls and equipment must be installed in accordance with manufacturer's instructions.
§ 150.0(k)2E:	Interior Switches and Controls. Controls must not bypass a dimmer, occupant sensor, or vacancy sensor function if the control is installed to comply with § 150.0(k)1F.*
§ 150.0(k)2F:	Interior Switches and Controls. Lighting controls must comply with the applicable requirements of § 110.9.



2019 Low-Rise Residential Mandatory Measures Summary

§ 150.0(h)3A:	Clearances. Air conditioner and heat pump outdoor condensing units must have a clearance of at least five feet from the outlet of any dryer.
§ 150.0(h)3B:	Liquid Line Drier. Air conditioners and heat pump systems must be equipped with liquid line filter driers if required, as specified by the manufacturer's instructions.
§ 150.0(i)1:	Storage Tank Insulation. Unfired hot water tanks, such as storage tanks and backup storage tanks for solar water-heating systems, must have a minimum of R-12 external insulation or R-16 internal insulation where the internal insulation R-value is indicated on the exterior of the tank.
§ 150.0(i)2A:	Water Piping, Solar Water-heating System Piping, and Space Conditioning System Line Insulation. All domestic hot water piping must be insulated as specified in Section 609.11 of the California Plumbing Code. In addition, the following piping conditions must have a minimum insulation wall thickness of one inch or a minimum insulation R-value of 7.7: the first five feet of cold water pipes from the storage tank; all hot water piping with a nominal diameter equal to or greater than 3/4 inch and less than one inch; all hot water piping with a nominal diameter less than 3/4 inch that is associated with a domestic hot water recirculation system, from the heating source to storage tank or between tanks, buried below grade, and from the heating source to kitchen fixtures.*
§ 150.0(j)3:	Insulation Protection. Piping insulation must be protected from damage, including that due to sunlight, moisture, equipment maintenance, and wind as required by Section 120.3(b). Insulation exposed to weather must be water retardant and protected from UV light (no adhesive tapes). Insulation covering chilled water piping and refrigerant suction piping located outside the conditioned space must include, or be protected by, a Class I or Class II vapor retarder. Pipe insulation buried below grade must be installed in a waterproof and non-crushable casing or sleeve.
§ 150.0(n)1:	Gas or Propane Water Heating Systems. Systems using gas or propane water heaters to serve individual dwelling units must include all of the following: A dedicated 125 volt, 20 amp electrical receptacle connected to the electric panel with a 120/240 volt 3 conductor, 10 AWG copper branch circuit, within three feet of the water heater without obstruction. Both ends of the unused conductor must be labeled with the word "spare" and be electrically isolated. Have a reserved single pole circuit breaker space in the electrical panel adjacent to the circuit breaker for the branch circuit and labeled with the words "Future 240V Use"; a Category III or IV vent, or a Type B vent with straight pipe between the outside termination and the space where the water heater is installed; a condensate drain that is no more than two inches higher than the base of the water heater, and allows natural draining without pump assistance; and a gas supply line with a capacity of at least 200,000 Btu per hour.
§ 150.0(n)2:	Recirculating Loops. Recirculating loops serving multiple dwelling units must meet the requirements of § 110.3(c)5.
§ 150.0(n)3:	Solar Water-Heating Systems. Solar water-heating systems and collectors must be certified and rated by the Solar Rating and Certification Corporation (SRCC), the International Association of Plumbing and Mechanical Officials, Research and Testing (IAPMO R&T), or by a listing agency that is approved by the Executive Director.
Ducts and Fans Measures:	
§ 110.8(e)3:	Ducts. Insulation installed on an existing space-conditioning duct must comply with § 604.0 of the California Mechanical Code (CMC). If a contractor installs the insulation, the contractor must certify to the customer, in writing, that the insulation meets this requirement.
§ 150.0(m)1:	CMC Compliance. All air distribution system ducts and plenums must meet the requirements of the CMC §§ 601.0, 602.0, 603.0, 604.0, 605.0 and ANSISMACNA-006-2006 HVAC Duct Construction Standards Metal and Flexible 3rd Edition. Portions of supply-air and return-air ducts and plenums must be insulated to a minimum installed level of R-6.0 or a minimum installed level of R-4.2 when ducts are entirely in conditioned space as confirmed through field verification and diagnostic testing (RA3.1, 4.3.8). Portions of the duct system completely exposed and surrounded by directly conditioned space are not required to be insulated. Connections of metal ducts and inner core of flexible ducts must be mechanically fastened. Openings must be sealed with mastic, tape, or other duct-closure system that meets the applicable requirements of UL 181, UL 181A, or UL 181B or aerosol sealant that meets the requirements of UL 723. If mastic or tape is used to seal openings greater than ¼ inch, the combination of mastic and either mesh or tape must be used. Building cavities, support platforms for air handlers, and plenums designed or constructed with materials other than sealed sheet metal, duct board or flexible duct must not be used to convey conditioned air. Building cavities and support platforms may contain ducts. Ducts installed in cavities and support platforms must not be compressed to cause reductions in the cross-sectional area.*
§ 150.0(m)2:	Factory-Fabricated Duct Systems. Factory-fabricated duct systems must comply with applicable requirements for duct construction, connections, and closures; joints and seams of duct systems and their components must not be sealed with cloth back rubber adhesive duct tapes unless such tape is used in combination with mastic and draw bands.
§ 150.0(m)3:	Field-Fabricated Duct Systems. Field-fabricated duct systems must comply with applicable requirements for: pressure-sensitive tapes, mastics, sealants, and other requirements specified for duct construction.
§ 150.0(m)7:	Backdraft Damper. Fan systems that exchange air between the conditioned space and outdoors must have backdraft or automatic dampers.
§ 150.0(m)8:	Gravity Ventilation Dampers. Gravity ventilating systems serving conditioned space must have either automatic or readily accessible, manually operated dampers in all openings to the outside, except combustion inlet and outlet air openings and elevator shaft vents.
§ 150.0(m)9:	Protection of Insulation. Insulation must be protected from damage, sunlight, moisture, equipment maintenance, and wind. Insulation exposed to weather must be suitable for outdoor service. For example, protected by aluminum, sheet metal, painted canvas, or plastic cover. Cellular foam insulation must be protected as above or painted with a coating that is water retardant and provides shielding from solar radiation.
§ 150.0(m)10:	Porous Inner Core Flex Duct. Porous inner core flex ducts must have a non-porous layer between the inner core and outer vapor barrier.
§ 150.0(m)11:	Duct System Sealing and Leakage Test. When space conditioning systems use forced air duct systems to supply conditioned air to an occupiable space, the ducts must be sealed and duct leakage tested, as confirmed through field verification and diagnostic testing, in accordance with § 150.0(m)11 and Reference Residential Appendix RA3.
§ 150.0(m)12:	Air Filtration. Space conditioning systems with ducts exceeding 10 feet and the supply side of ventilation systems must have MERV 13 or equivalent filters. Filters for space conditioning systems must have a two inch depth or can be one inch if sized per Equation 150.0-A. Pressure drops and labeling must meet the requirements in § 150.0(m)12. Filters must be accessible for regular service.*
§ 150.0(m)13:	Space Conditioning System Airflow Rate and Fan Efficacy. Space conditioning systems that use ducts to supply cooling must have a hole for the placement of a static pressure probe, or a permanently installed static pressure probe in the supply plenum. Airflow must be 350 CFM per ton of nominal cooling capacity, and an air-handling unit fan efficiency ≤ 0.45 watts per CFM for gas furnace air handlers and ≤ 0.58 watts per CFM for all others. Small duct high velocity systems must provide an airflow ≥ 250 CFM per ton of nominal cooling capacity, and an air-handling unit fan efficiency ≤ 0.62 watts per CFM. Field verification testing is required in accordance with Reference Residential Appendix RA3.3.*

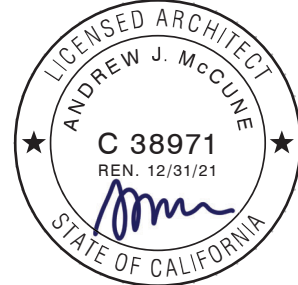

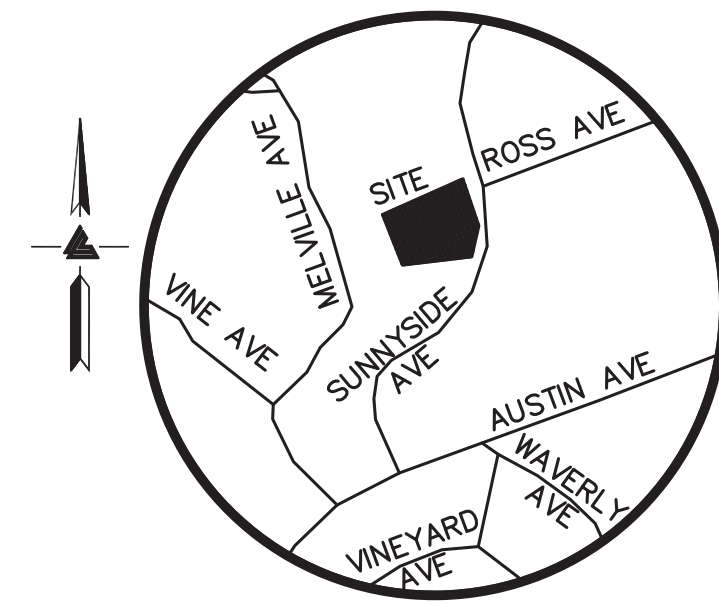VICINITY MAP
NO SCALE**EASEMENT NOTE**

45 SUNNYSIDE
THERE ARE NO RECORD EASEMENTS LISTED PER PRELIMINARY TITLE REPORT ISSUED BY STEWART TITLE COMPANY, ORDER NO. 01180-113793, DATED AS OF JULY 1, 2014

49 SUNNYSIDE
EASEMENTS ARE SHOWN PER PRELIMINARY TITLE REPORT ISSUED BY FIRST AMERICAN TITLE COMPANY, ORDER NO. 2103-6440832, DATED AS OF NOVEMBER 12, 2020

FEMA FLOOD NOTE


PROPERTY COMPLETELY OUT OF SPECIAL FLOOD HAZARD AREA (SFHA) PER CURRENT FLOOD INSURANCE RATE MAP.

SITE BENCHMARK

SURVEY CONTROL POINT
MAG AND SHINER SET IN ASPHALT
ELEVATION = 102.07'
(ASSUMED)

TREE NOTE

TREE SIZE, TYPE AND DRIPLINES ARE BASED ON A VISUAL OBSERVATION. FINAL DETERMINATION SHOULD BE MADE BY THE PROJECT ARBORIST.

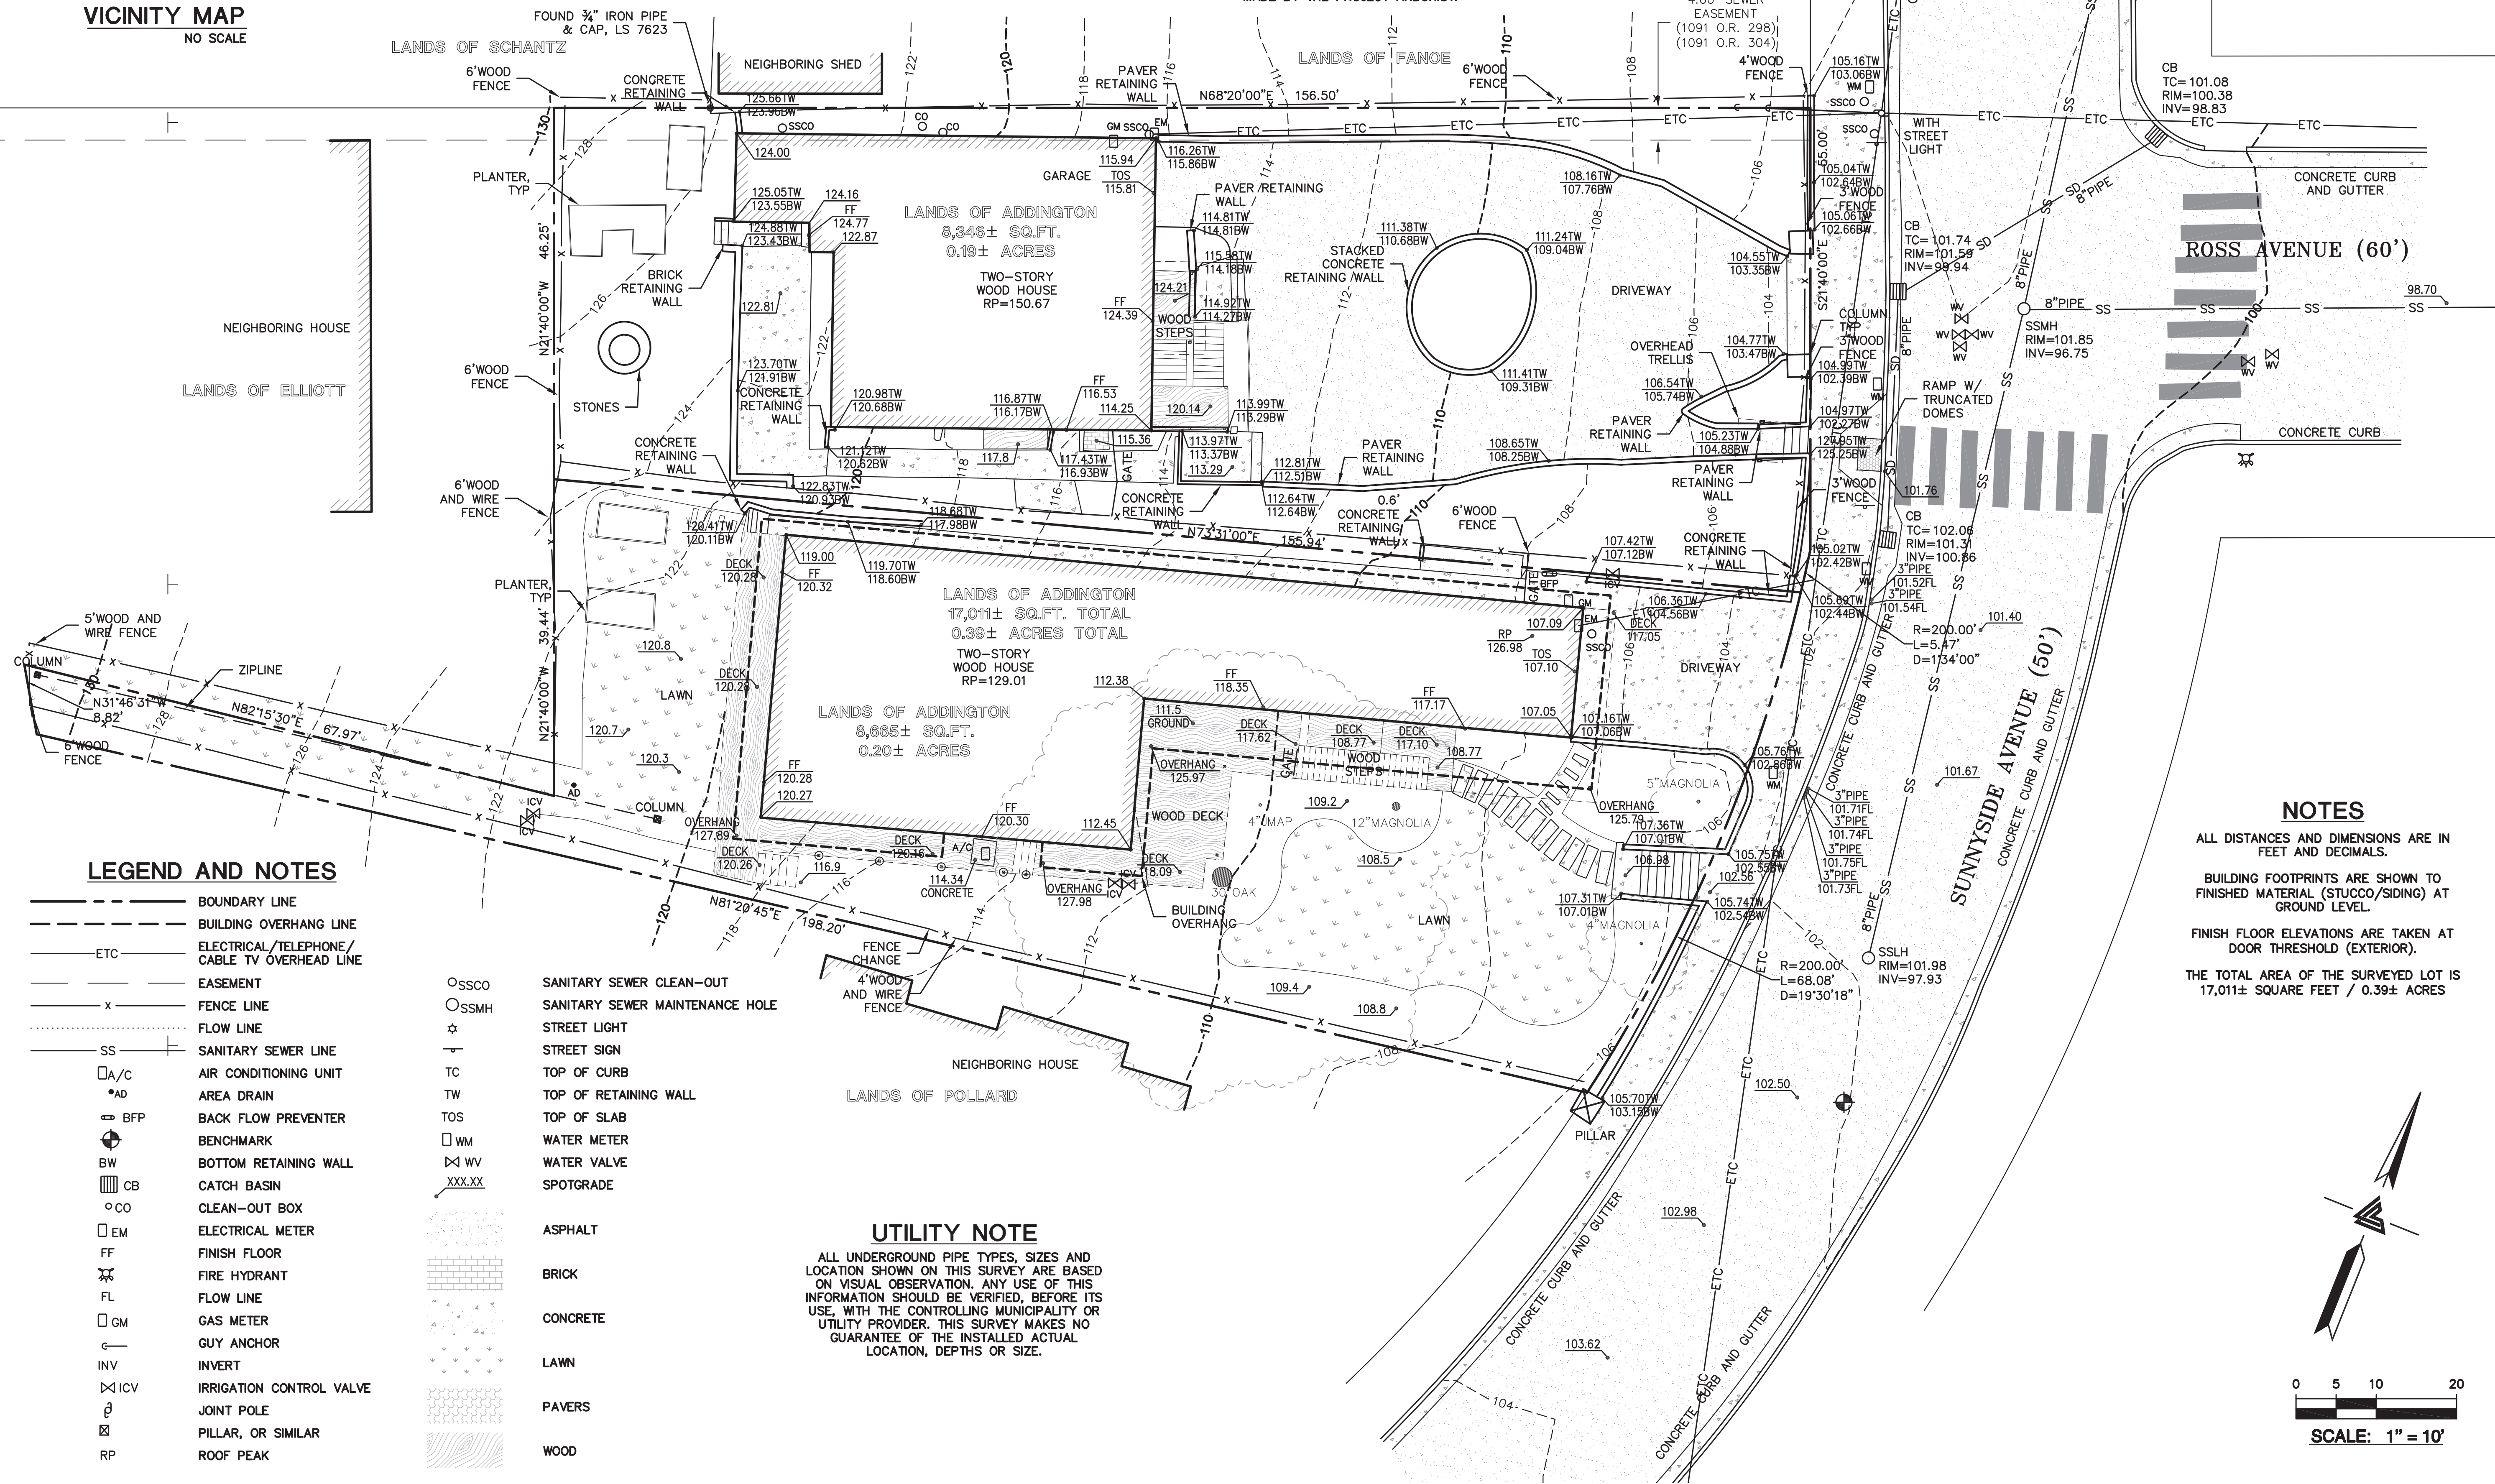**LEGEND AND NOTES**

—	BOUNDARY LINE
- - -	BUILDING OVERHANG LINE
- . - . -	ELECTRICAL/TELEPHONE/CABLE TV OVERHEAD LINE
- - -	ETC
- - -	EASEMENT
- x -	FENCE LINE
- . . . -	FLOW LINE
- - -	SANITARY SEWER LINE
□ A/C	AIR CONDITIONING UNIT
• AD	AREA DRAIN
⊖ BFP	BACK FLOW PREVENTER
⊕	BENCHMARK
BW	BOTTOM RETAINING WALL
▨ CB	CATCH BASIN
○ CO	CLEAN-OUT BOX
□ EM	ELECTRICAL METER
FF	FINISH FLOOR
⊗	FIRE HYDRANT
FL	FLOW LINE
□ GM	GAS METER
—	GUY ANCHOR
INVERT	INVERT
⊗ ICV	IRRIGATION CONTROL VALVE
⊕	JOINT POLE
⊗	PILLAR, OR SIMILAR
RP	ROOF PEAK

○ SSCO	SANITARY SEWER CLEAN-OUT
○ SSMH	SANITARY SEWER MAINTENANCE HOLE
⊕	STREET LIGHT
⊕	STREET SIGN
TC	TOP OF CURB
TW	TOP OF RETAINING WALL
TOS	TOP OF SLAB
□ WM	WATER METER
⊗ WV	WATER VALVE
XXX.XX	SPOTGRADE

ASPHALT
BRICK
CONCRETE
LAWN
PAVERS
WOOD

UTILITY NOTE

ALL UNDERGROUND PIPE TYPES, SIZES AND LOCATION SHOWN ON THIS SURVEY ARE BASED ON VISUAL OBSERVATION. ANY USE OF THIS INFORMATION SHOULD BE VERIFIED, BEFORE ITS USE, WITH THE CONTROLLING MUNICIPALITY OR UTILITY PROVIDER. THIS SURVEY MAKES NO GUARANTEE OF THE INSTALLED ACTUAL LOCATION, DEPTHS OR SIZE.

NOTES

ALL DISTANCES AND DIMENSIONS ARE IN FEET AND DECIMALS.

BUILDING FOOTPRINTS ARE SHOWN TO FINISHED MATERIAL (STUCCO/SIDING) AT GROUND LEVEL.

FINISH FLOOR ELEVATIONS ARE TAKEN AT DOOR THRESHOLD (EXTERIOR).

THE TOTAL AREA OF THE SURVEYED LOT IS 17,011± SQUARE FEET / 0.39± ACRES

0 5 10 20
SCALE: 1" = 10'



LEA & BRAZE ENGINEERING, INC.
CIVIL ENGINEERS & LAND SURVEYORS

REGIONAL OFFICES:
ROSEVILLE
DUBLIN
SAN JOSE

MAIN OFFICE:
2485 INDUSTRIAL PKWY WEST
HAYWARD, CALIFORNIA 94545
(510) 887-4086

WWW.LEABRAZE.COM

PO Box 78115
San Francisco, CA 94107
T (415) 850-8500
www.andrewmccune.com



49 SUNNYSIDE AVE
SAN ANSELMO, CA 94960

**TOPOGRAPHIC SURVEY**

REVISIONS	BY
JOB NO: 2201721	PERMIT
DATE: 2-11-21	DATE: JULY 01, 2022
SCALE: 1"=10'	SCALE
FIELD BY: BW	DRAWN NAME
DRAWN BY: ZB	SITE SURVEY
SHEET NO:	


SU1

1 OF 1 SHEETS


SHEET NUMBER

A0.100




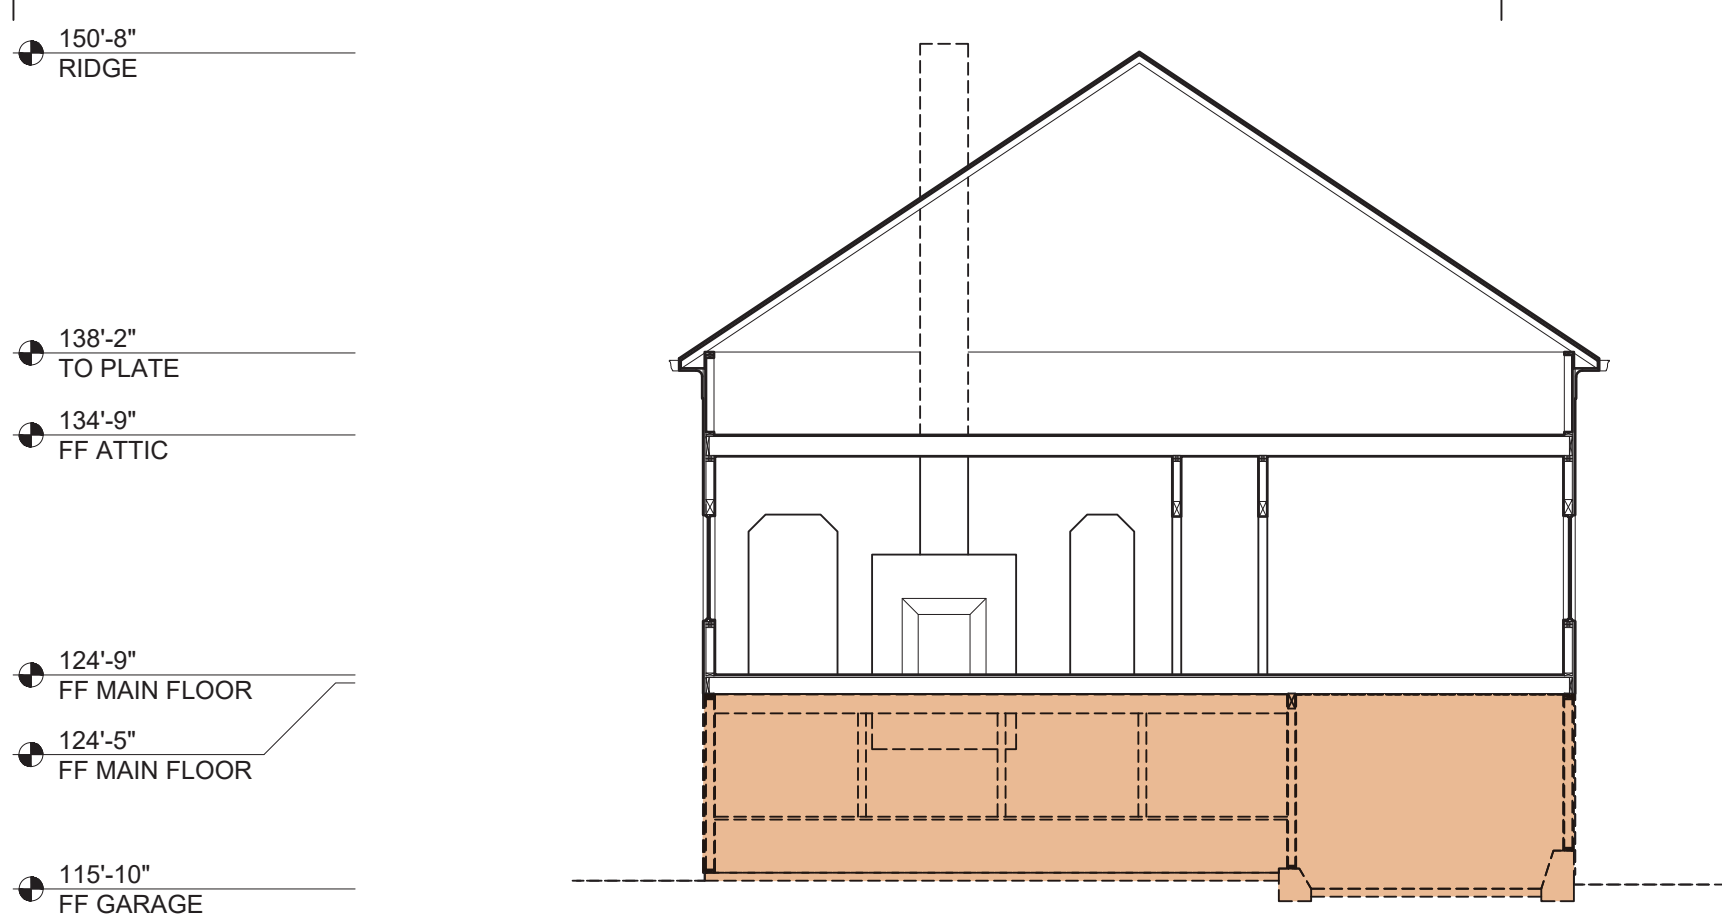


7 SECTION

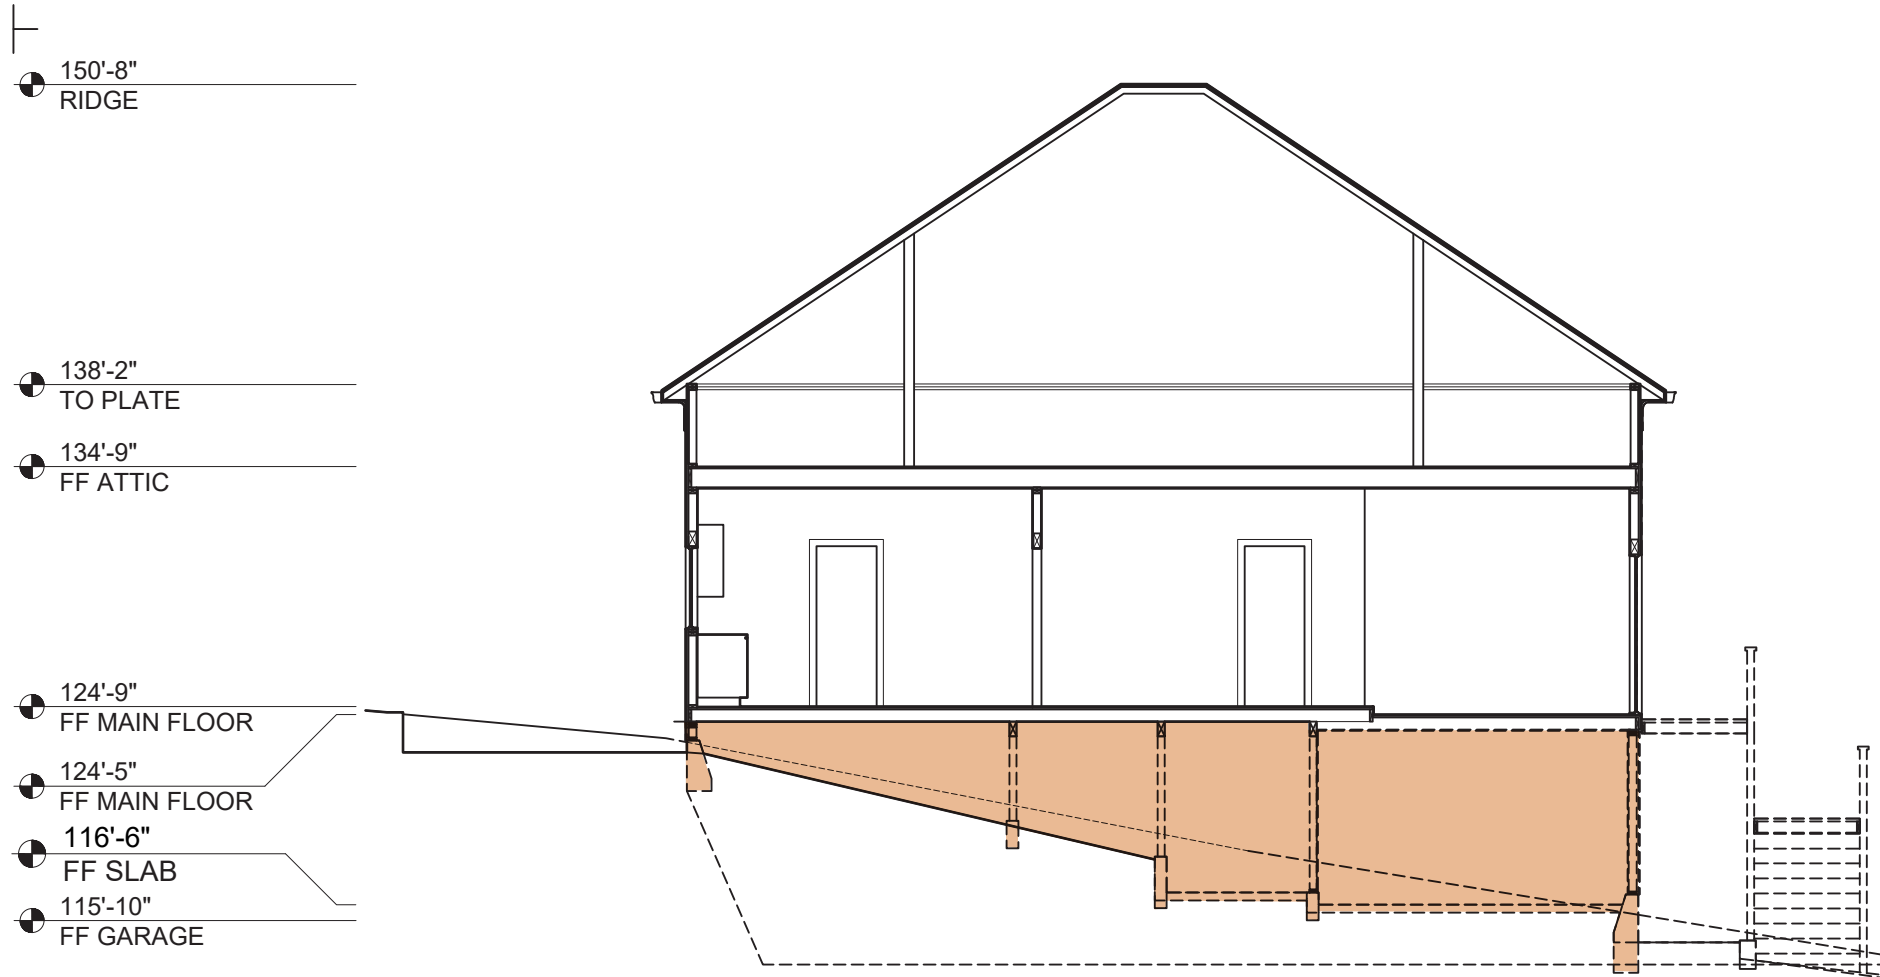


6 SECTION

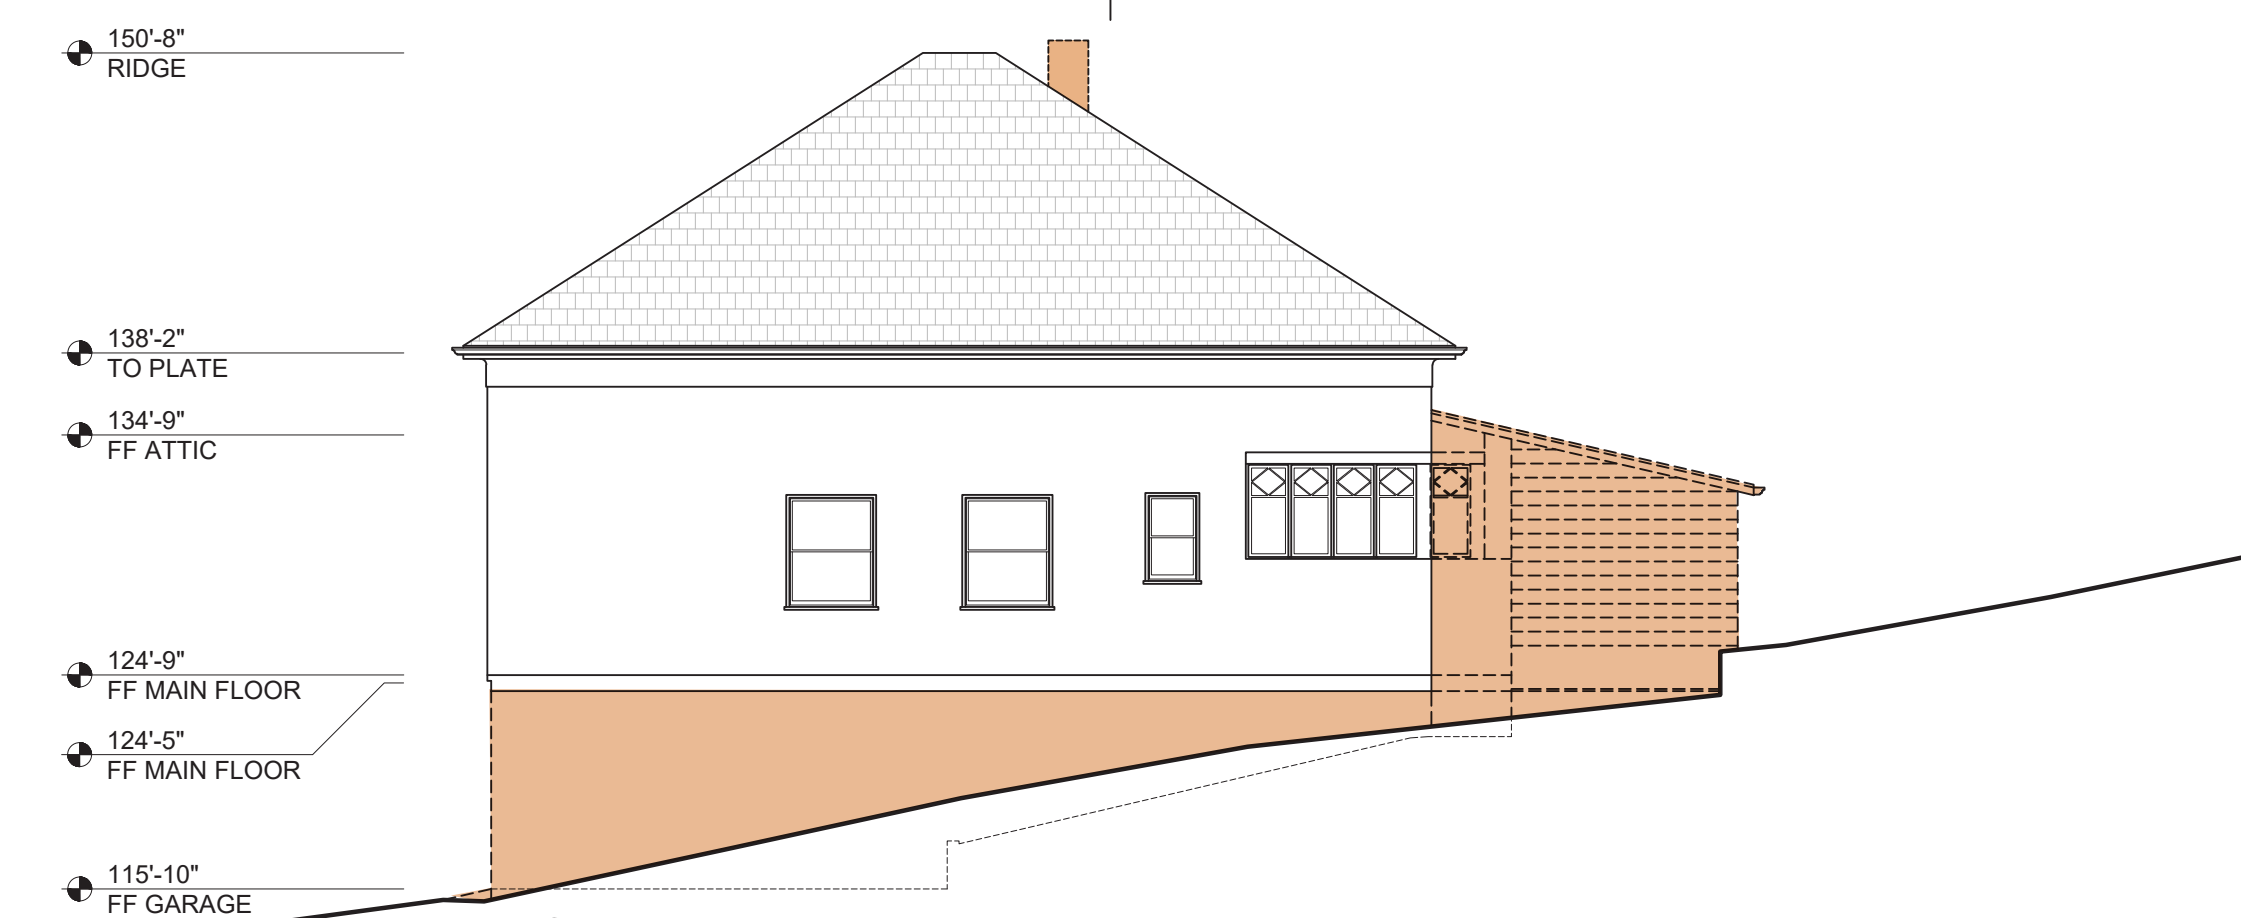


5 NORTH (SIDE) ELEVATION

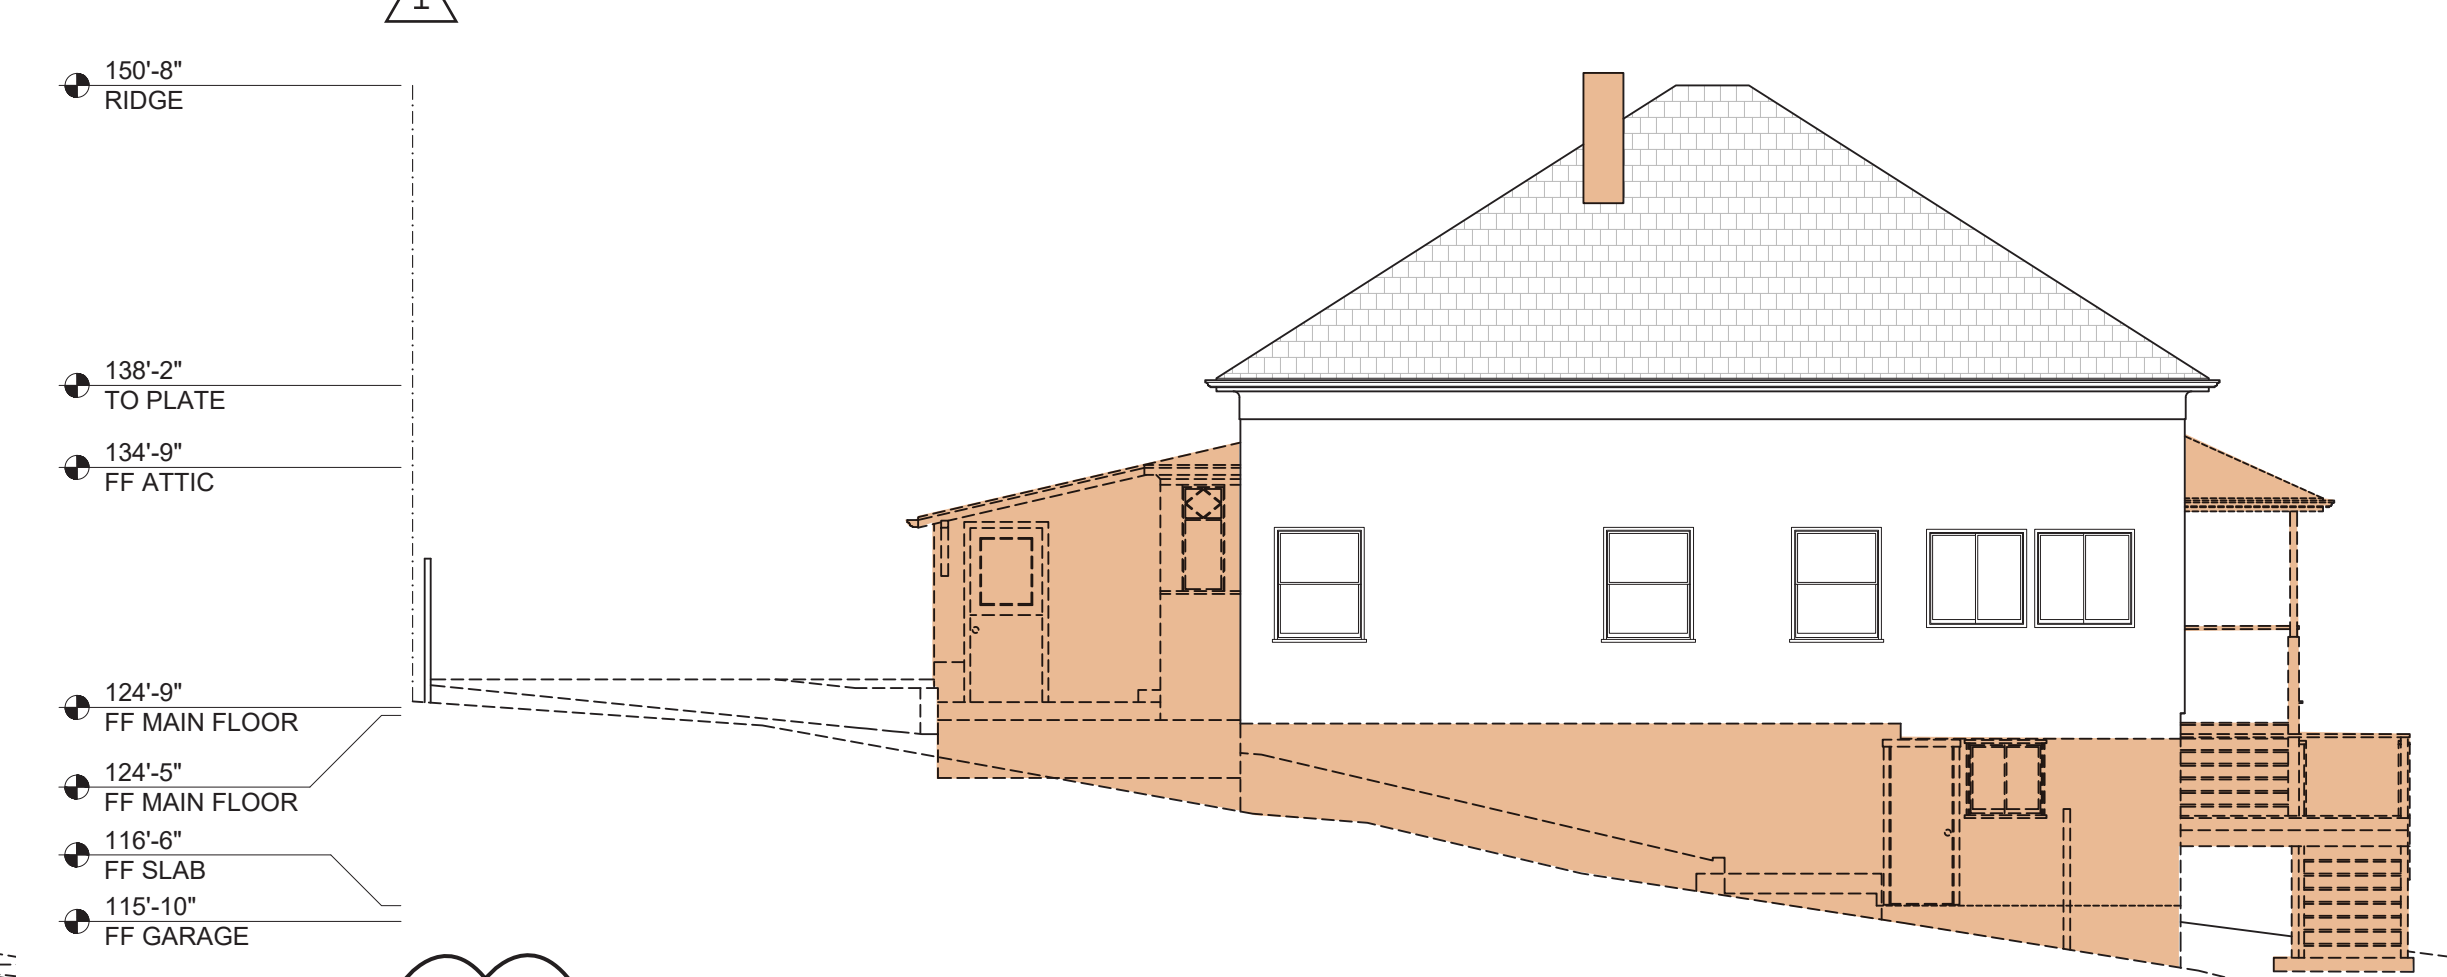

4 SOUTH (SIDE) ELEVATION

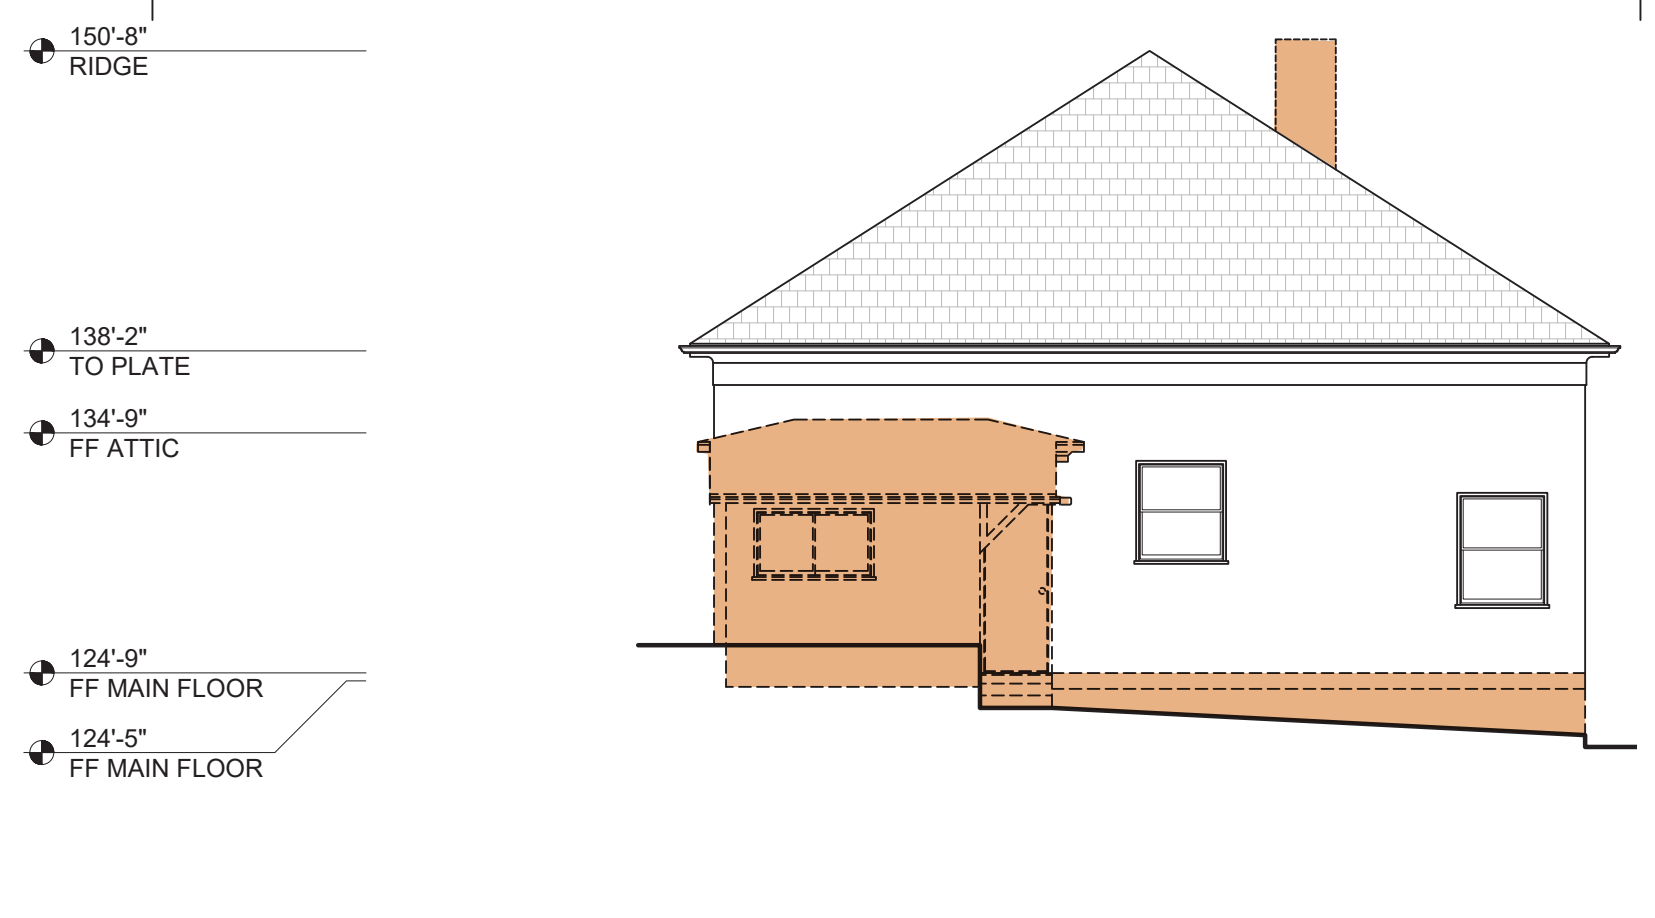


3 WEST (REAR) ELEVATION

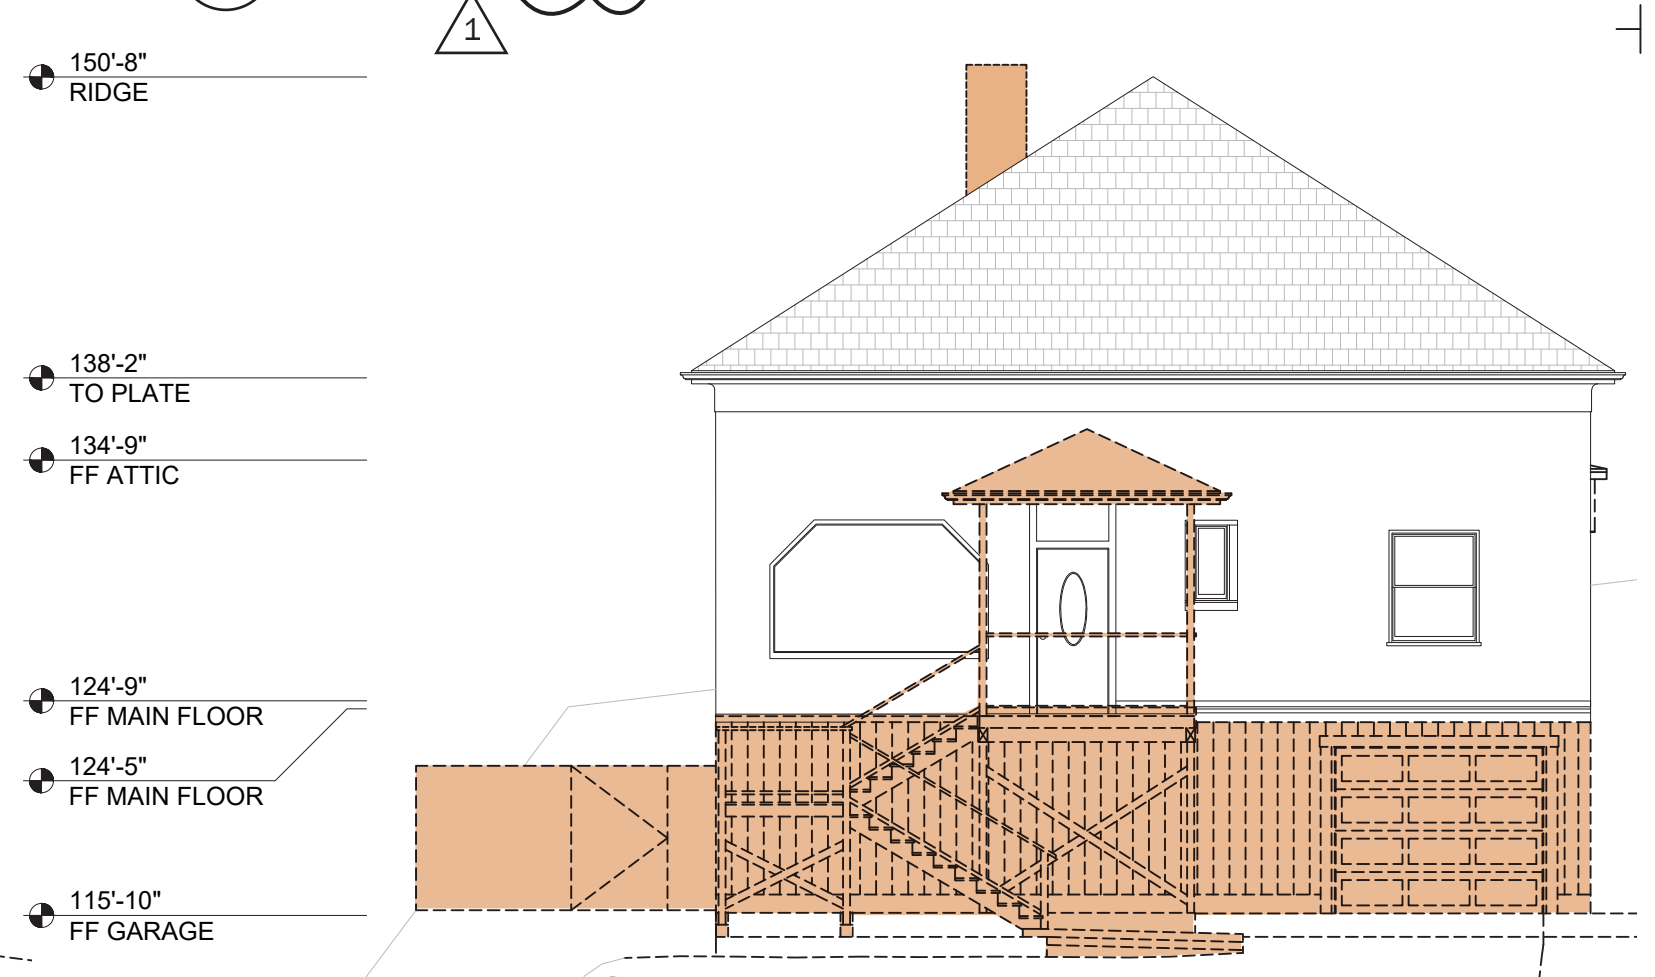


2 EAST (FRONT) ELEVATION


- 1 DEMOLISH EXISTING FOUNDATION (FOOTINGS, STEM WALLS, ETC.), & GARAGE SLAB.
- 2 CLEAR AND GRUB YARD. REMOVE BUILT ELEMENTS.
- 3 DEMOLISH LAUNDRY ROOM & PORTION OF BEDROOM.
- 4 DEMOLISH EXTERIOR STAIR AND SUPPORTS.
- 5 DEMOLISH CONCRETE SITE WALKS.

NOTE:
ALL VEGETATION AND CONSTRUCTION MATERIALS ARE TO BE MAINTAINED AWAY FROM THE RESIDENCE DURING CONSTRUCTION. (DEFENSIBLE SPACE)

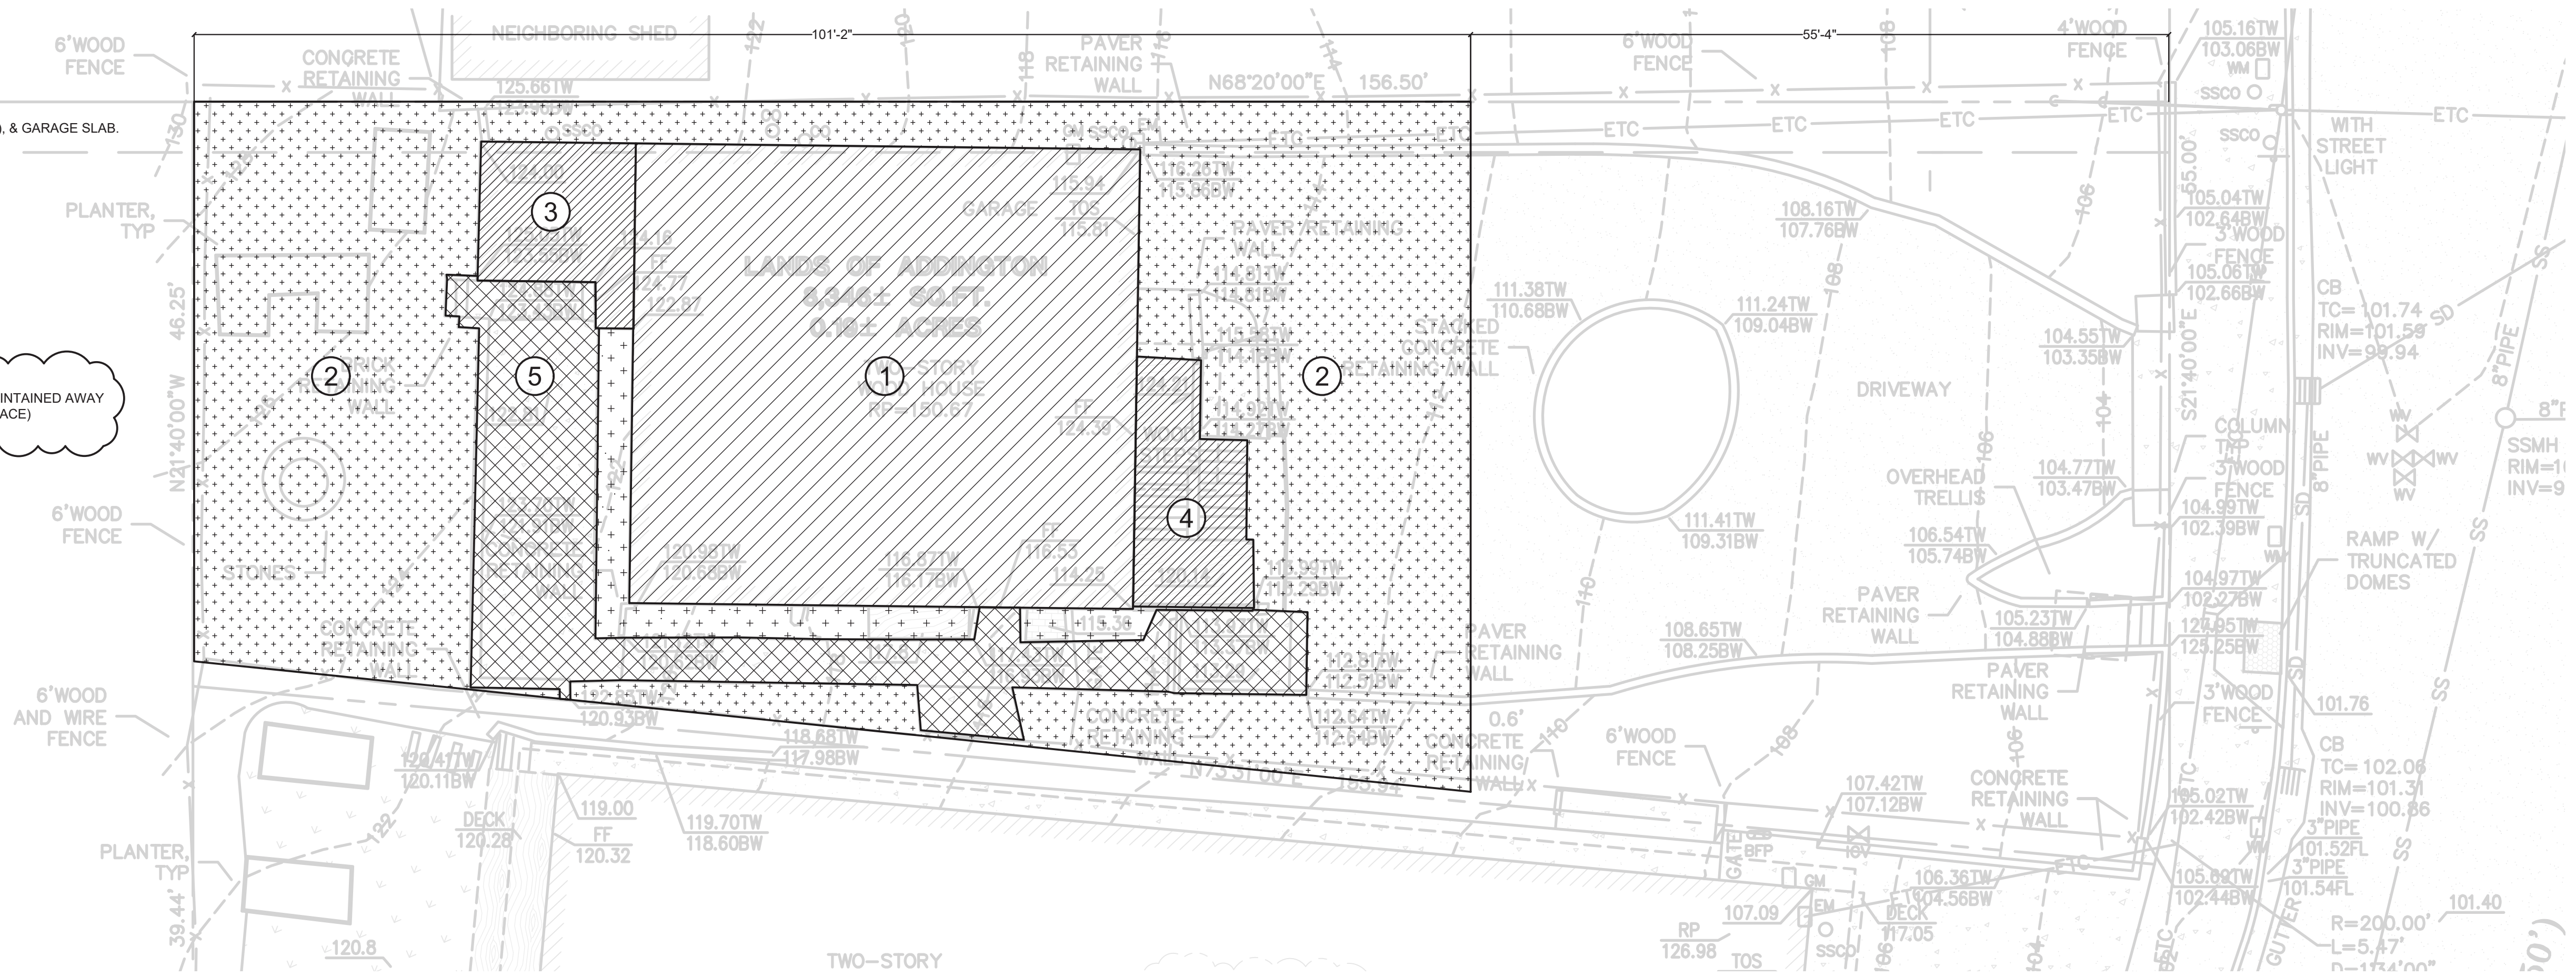

1 SITE PLAN

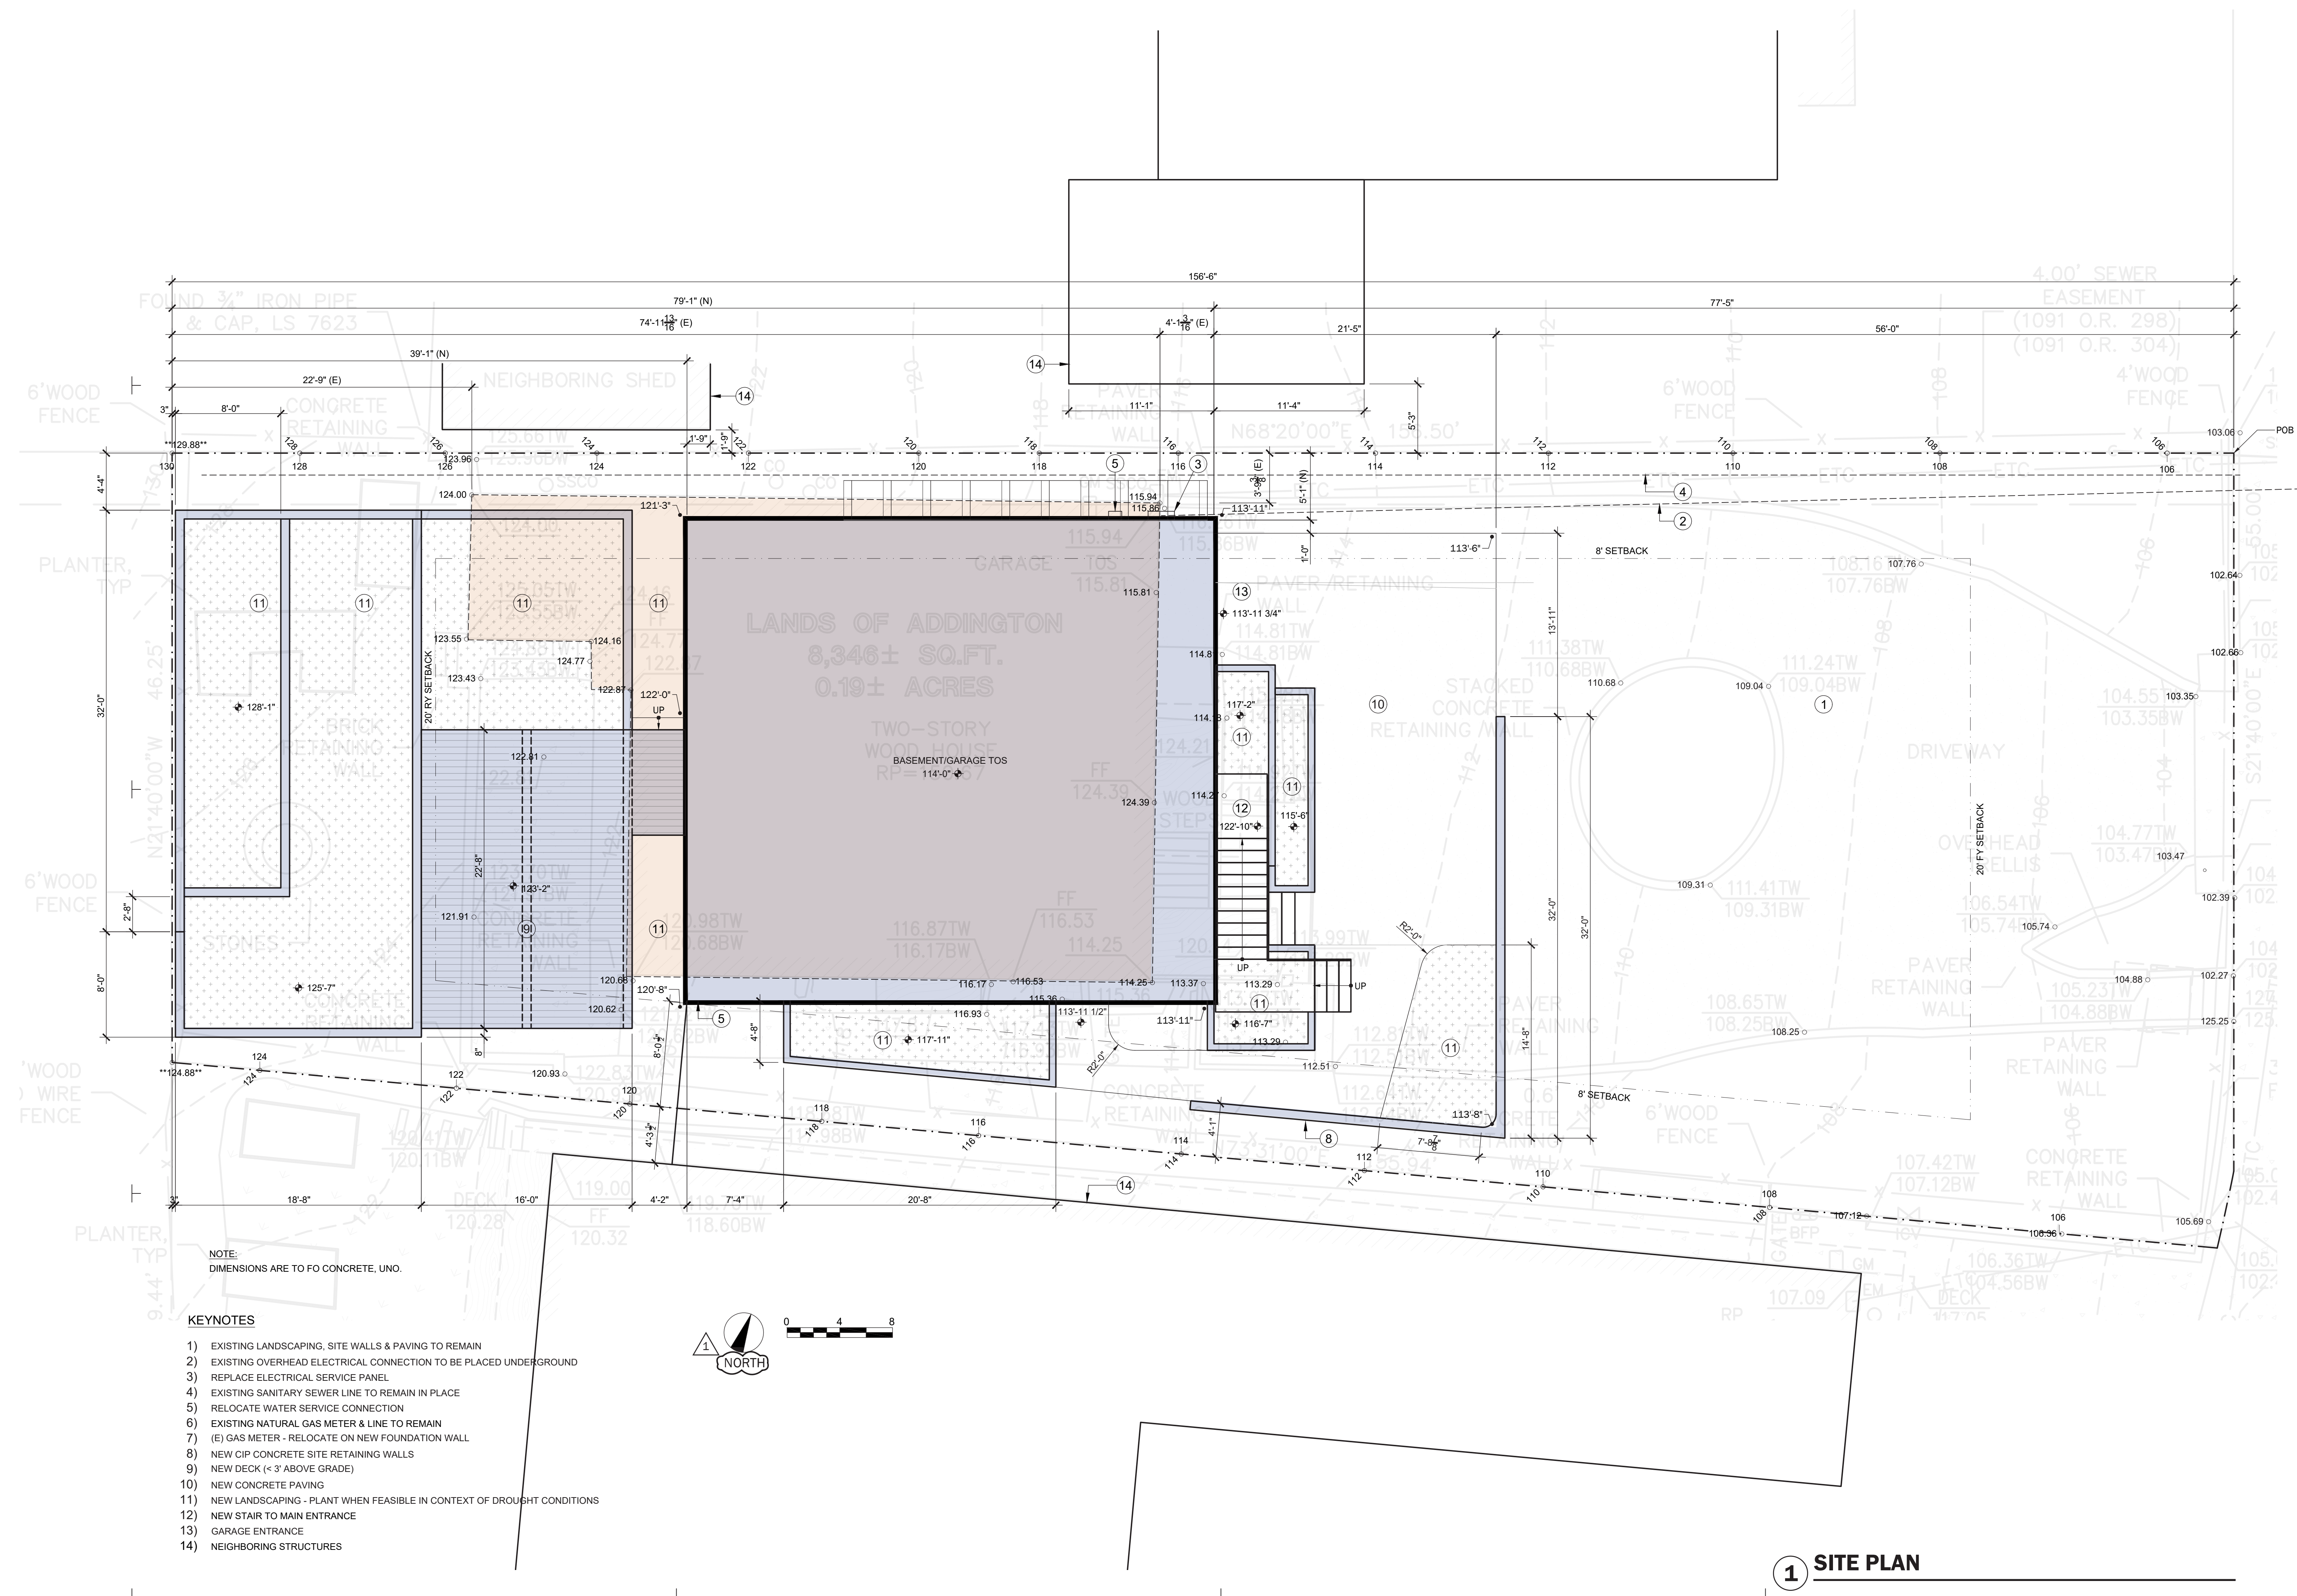

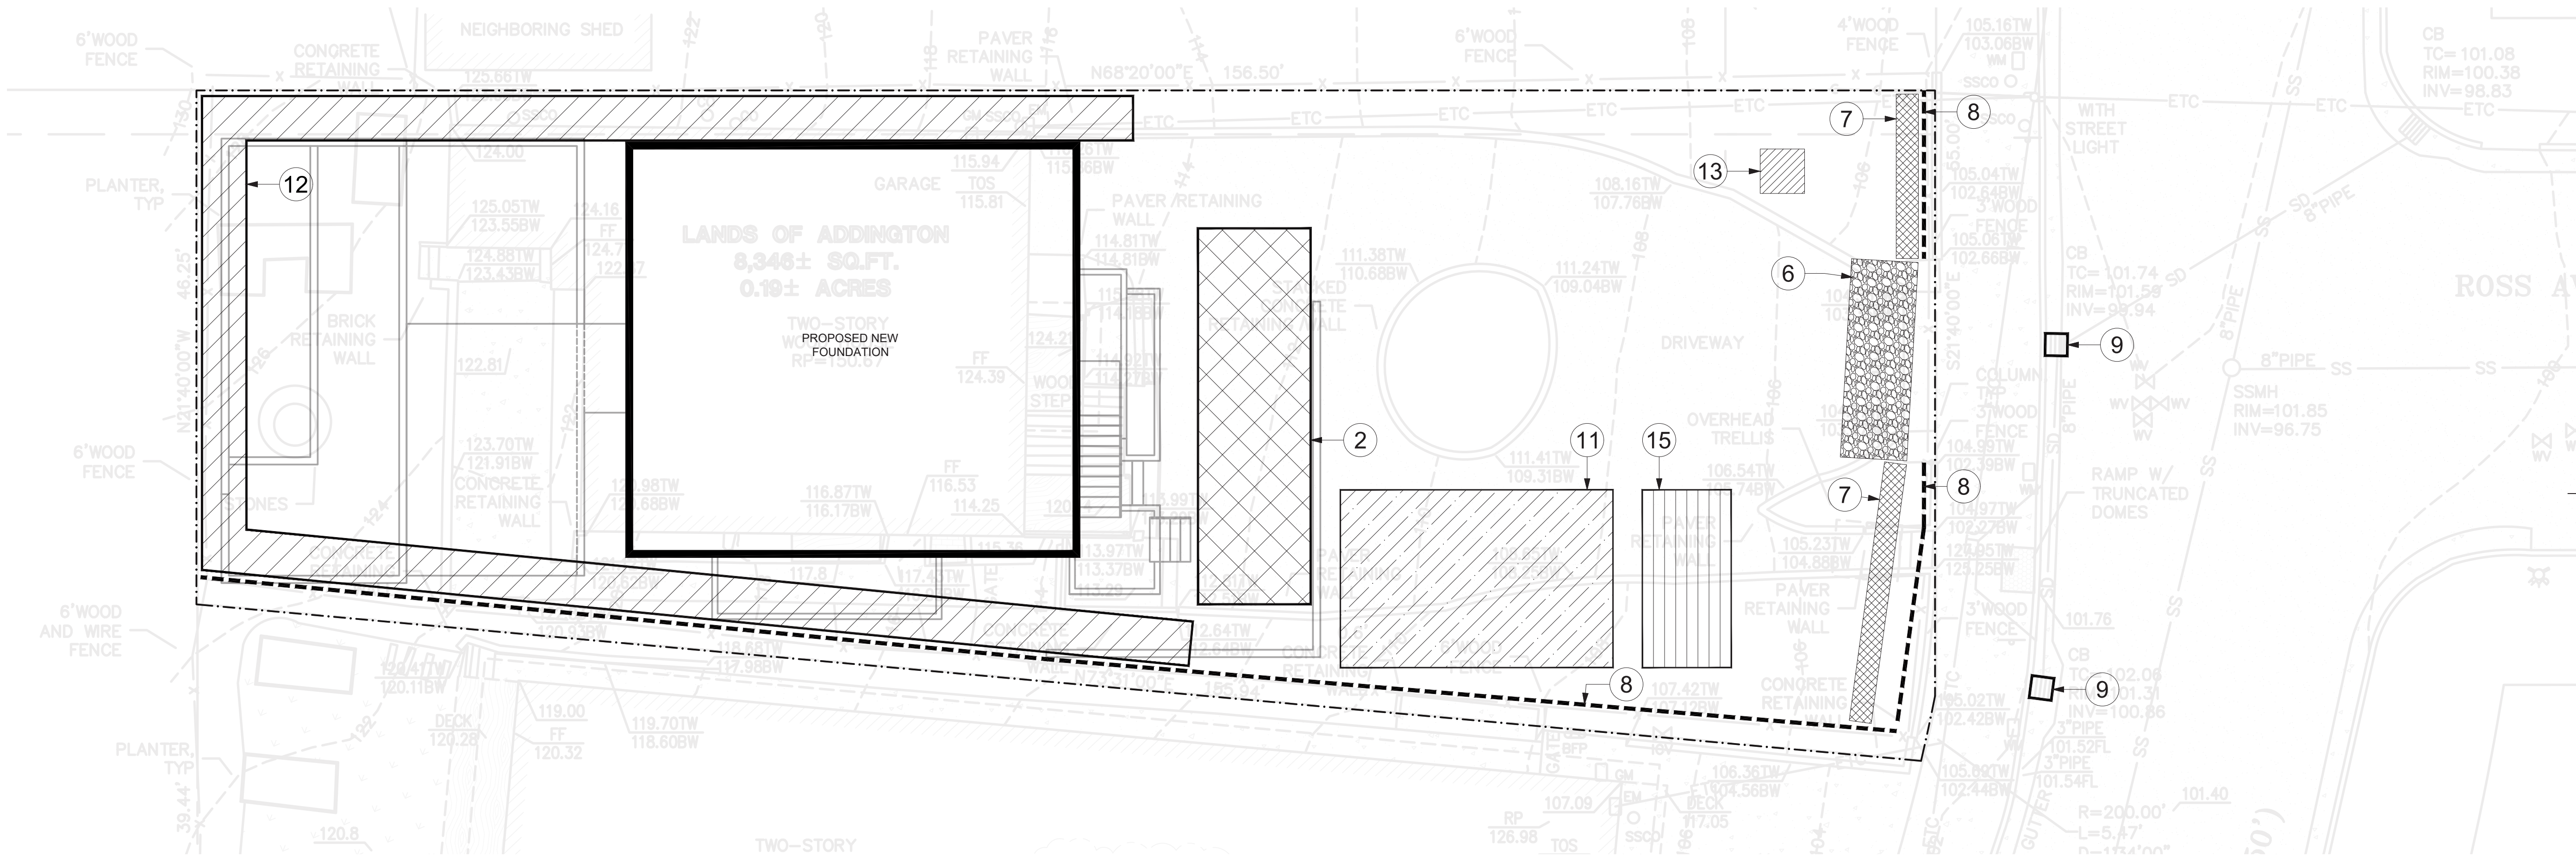


NOTE: NUMBERED CALLOUTS REFERENCE THE CONTROL MEASURES PER MARIN COUNTY STORMWATER POLLUTION PREVENTION PROGRAM.

1 SITE PLAN



Marin County Stormwater Pollution Prevention Program
Minimum Control Measures
For Small Construction Projects


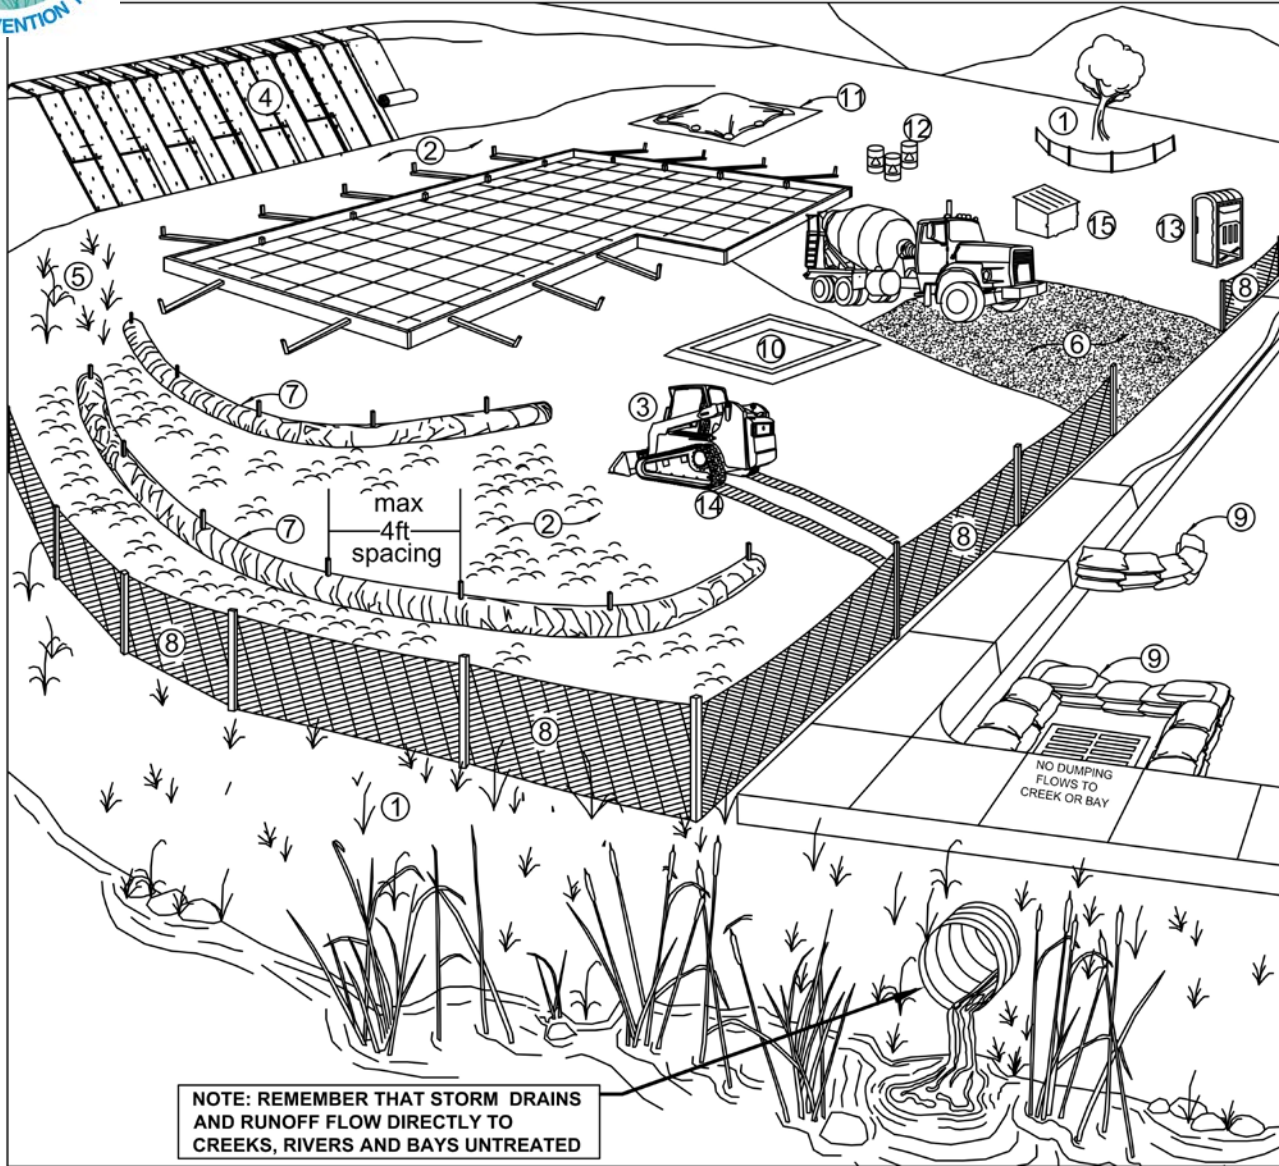


Erosion Controls	Sediment Controls	Good Housekeeping
NS Scheduling	6. Tracking Controls	10. Concrete Washout
1. Preserve Vegetation & Creek Set Backs	7. Fiber Rolls	11. Stockpile Management
2. Soil Cover	8. Silt Fence	12. Hazardous Material Management
3. Soil Preparation/ Roughening	9. Drain Inlet Protection	13. Sanitary Waste Management
4. Erosion Control Blankets	NS Trench Dewatering	14. Equipment and Vehicle Maintenance
5. Revegetation		15. Litter and Waste Management

NOTE: Select an effective combination of control measures from each category, Erosion Control, Sediment Control, and Good Housekeeping. Control measures shall be continually implemented and maintained throughout the project until activities are complete, disturbed areas are stabilized with permanent erosion controls, and the local agency has signed off on permits that may have been required for the project. Inspect and maintain the control measures before and after rain events, and as required by the local agency or state permit. More detailed information on the BMPs can be found in the related California Stormwater Quality Association (CASQA) and California Department of Transportation (Caltrans) BMP Factsheets. CASQA factsheets are available by subscription in the California Best Management Practices Handbook Portal; Construction at <http://www.casqa.org>. Caltrans factsheets are available in the Construction Site BMP Manual at <https://dot.ca.gov/programs/construction/storm-water-and-water-pollution-control/manuals-and-handbooks>. Visit www.mcsotopp.org for more information on construction site management and Erosion and Sediment Control Plans.

If you require materials in alternative formats, please contact:
415-473-4381 voice/TTY or disabilityaccess@co.marin.ca.us

Control Measure	General Description
Erosion Control Best Management Practices	
N/A Scheduling	Plan the project and develop a schedule showing each phase of construction. Schedule construction activities to reduce erosion potential, such as scheduling ground disturbing activities during the summer and phasing projects to minimize the amount of area disturbed. For more info see the following factsheets: CASQA: EC-1; or Caltrans: SS-1.
1 Preserve Existing Vegetation and Creek Setbacks	Preserve existing vegetation to the extent possible, especially along creek buffers. Show creek buffers on maps and identify areas to be preserved in the field with temporary fencing. Check with the local Planning and Public Works Departments for specific creek set back requirements. For more info see the following factsheets: CASQA: EC-2; or Caltrans: SS-2.
2 Soil Cover	Cover exposed soil with straw mulch and tackifier (or equivalent). For more info see the following factsheets: CASQA: EC-3, EC-5, EC-6, EC-7, EC-8, EC-14, EC-16; or Caltrans: SS-2, SS-4, SS-5, SS-6, SS-7, SS-8.
3 Soil Preparation/ Roughening	Soil preparation is essential to vegetation establishment and BMP installation. It includes soil testing and amendments to promote vegetation growth as well as roughening surface soils by mechanical methods (decompacting, scarifying, siltar stepping, etc.). For more info see the following factsheets: CASQA: EC-15.
4 Erosion Control Blankets	Install erosion control blankets (or equivalent) on disturbed sites with 3:1 slopes or steeper. Use wildlife-friendly blankets made of biodegradable natural materials. Avoid using blankets made with plastic netting or fixed aperture netting. See: http://www.coastal.ca.gov/nps/Wildlife-Friendly_Products.pdf . For more info see the following factsheets: CASQA: EC-7; or Caltrans: SS-7.
5 Revegetation	Re-vegetate areas of disturbed soil or vegetation as soon as practical. For more info see the following factsheets: CASQA: EC-4; or Caltrans: SS-4.
Sediment Control Best Management Practices	
6 Tracking Controls	Stabilize site entrance to prevent tracking soil offsite. Inspect streets daily and sweep street as needed. Require vehicles and workers to use stabilized entrance. Place crushed rock 12-inches deep over a geotextile, using angular rock between 4 and 6-in. Make the entrance as long as can be accommodated on the site, ideally long enough for 2 revolutions of the maximum tire size (16-20 feet long for most light trucks). Make the entrance wide enough to accommodate the largest vehicle that will access the site, ideally 10 feet wide with sufficient radii for turning in and out of the site. Rumble pads or rumble racks can be used in lieu of or in conjunction with rock entrances. Wheel washes may be needed where space is limited or where the site entrance and sweeping is not effective. For more info see the following factsheets: CASQA: TC-1; TC-3; or Caltrans: TC-1, TC-3.
7 Fiber Rolls	Use fiber rolls as a perimeter control measure, along contours of slopes, and around soil stockpiles. On slopes space rolls 10 to 20 feet apart (using closer spacing on steeper slopes). Install parallel to contour. If more than one roll is used in a row overlap roll do not abut. J-hook end of roll upslope. Install rolls per either Type 1 (stake rolls into shallow trenches) or Type 2 (stake in front and behind roll and lash with rope). Use wildlife-friendly fiber rolls made of biodegradable natural materials. Avoid using fiber rolls made with plastic netting or fixed aperture netting. See: http://www.coastal.ca.gov/nps/Wildlife-Friendly_Products.pdf . Manufactured linear sediment control or compost socks can be used in lieu of fiber rolls. For more info see the following factsheets: CASQA: SE-5 (Type 1), SE-12, SE-13; or Caltrans: SC-5 (Type 1 and Type 2).
8 Silt Fence	Use silt fence as a perimeter control measure, and around soil stockpiles. Install silt fence along contours. Key silt fence into the soil and stake. Do not use silt fence for concentrated water flows. Install fence at least 3 feet back from the slope to allow for sediment storage. Wire backed fence can be used for extra strength. Avoid installing silt fence on slopes because they are hard to maintain. Manufactured linear sediment control can be used in lieu of silt fences. For more info see the following factsheets: CASQA: SE-1; SE-12; or Caltrans: SC-1.
9 Drain Inlet Protection	Use gravel bags, (or similar product) around drain inlets located both onsite and in gutter as a last line of defense. Bags should be made of a woven fabric resistant to photo-degradation filled with 0.5-1-in washed crushed rock. Do not use sand bags or silt fence fabric for drain inlet protection. For more info see the following factsheets: CASQA: SE-10; or Caltrans: SC-10.
N/A Trench Dewatering	Follow MCSOTPPP BMPs for trench dewatering: http://www.marincounty.org/depts/pw/divisions/mcsotopp/development/-/media/Files/Departments/PW/mcsotopp/development/TrenchingSWSReqMCSOTPPPFinal09.pdf . For more info see the following factsheets: CASQA: NS-2; or Caltrans: NS-2.
Good Housekeeping Best Management Practices	
N/A Concrete Washout	Construct a lined concrete washout site away from storm drains, waterbodies, or other drainages. Ideally, place adjacent to stabilized entrance. Clean as needed and remove at end of project. For more info see the following factsheets: CASQA: WM-8; or Caltrans: WM-8.
11 Stockpile Management	Cover all stockpiles and landscape material and berm properly with fiber rolls or sand bags. Keep behind the site perimeter control and away from waterbodies. For more info see the following factsheets: CASQA: WM-3 or Caltrans: WM-3.
12 Hazardous Material Management	Hazardous materials must be kept in closed containers that are covered and within secondary containment; do not place containers directly on soil. For more info see the following factsheets: CASQA: WM-6; or Caltrans: WM-6.
13 Sanitary Waste Management	Place portable toilets near stabilized site entrance, behind the curb and away from gutters, storm drain inlets, and waterbodies. Tie or stake portable toilets to prevent tipping and equip units with overflow pan/tray (most vendors provide these). For more info see the following factsheets: CASQA: WM-9; NS-9; and NS-10; or Caltrans: NS-9, NS-9, and NS-10.
14 Equipment and Vehicle Maintenance	Prevent equipment fluid leaks onto ground by placing drip pans or plastic tarps under equipment. Immediately clean up any spills or drips. For more info see the following factsheets: CASQA: NS-8, NS-9, and NS-10; or Caltrans: NS-8, NS-9, and NS-10.
15 Litter and Waste Management	Designate waste collection areas on site. Use watertight dumpsters and trash cans; inspect for leaks. Cover at the end of each work day and when it is raining or windy. Arrange for regular waste collection. Pick up site litter daily. For more info see the following factsheets: CASQA: WM-5; or Caltrans: WM-5.

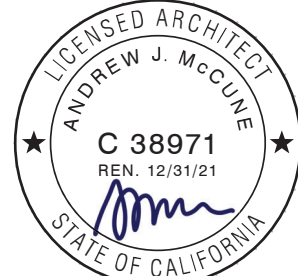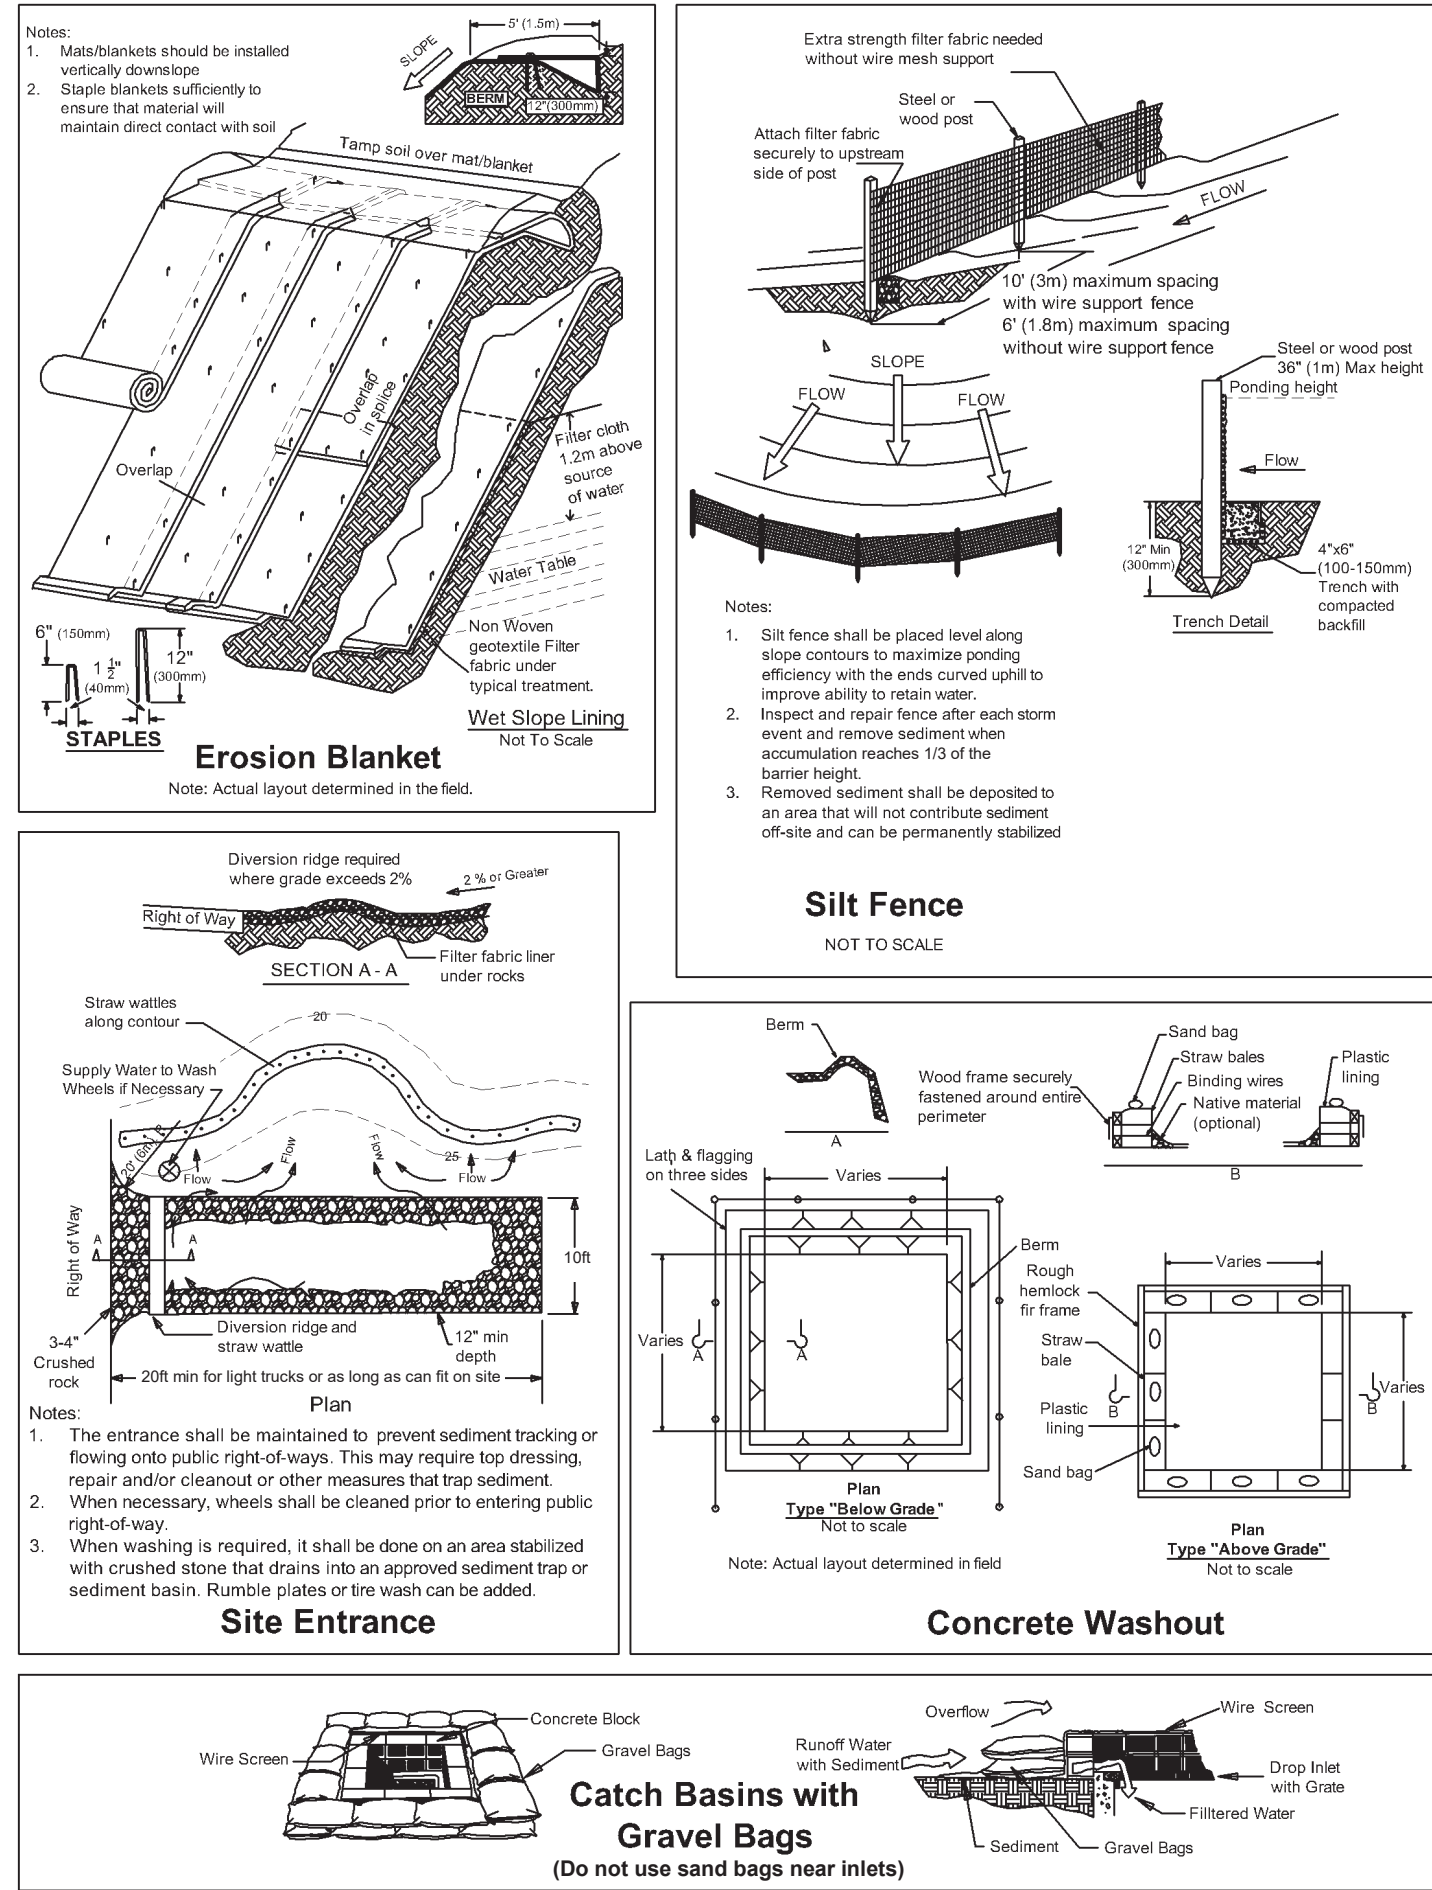

PLAN CHECK - RESPONSE 1

DRAWN BY
AIM
CHECKED BY
AIM
FILE NAME
49Sunnyside_01.dwg
CLIENT
PHILLIPS/McCUNE
PROJECT
49 SUNNYSIDE AVE
JOB NUMBER
2022-001
ISSUANCE
PERMIT
DATE
JULY 01, 2022
SCALE
1/8" = 1'-0"
DRAWING NAME

STORMWATER
POLLUTION BEST
MANAGEMENT
PRACTICES

- 1) EXISTING ASPHALT PAVEMENT TO REMAIN: 2099 SF
- 2) NEW FOUNDATION/BUILDING FOOTPRINT: 1460 SF
- 3) NEW PERMEABLE CONCRETE PAVERS OVER PERMEABLE MATERIAL BASE: 479 SF
- 4) NEW PLANTER WALLS & CONCRETE STEPS: 67 SF
- 5) NEW PLANTER WALLS & CONCRETE STEPS: 52 SF
- 6) NEW PLANTER/SITE WALLS: 134 SF
- 7) 4" DIA SLEEVE IN BASE OF WALL. LOCATE AT ELEVATION OF LOWER ADJACENT GRADE.
- 8) PERFORATED DRAIN LINE LOCATED AT BASE OF SLAB/FOOTING. SURROUNDED BY WASHED GRAVEL (3/8" MINUS) AND PREFORMED DRAINAGE SUBSTRATE.
- 9) DRAIN SET IN PLANTER. CONNECT TO PERFORATED DRAIN LINE.
- 10) 3" DIA DOWNSPOUTS FROM GUTTERS ABOVE (1 @ EACH BLDG CORNER) CONNECT TO PERFORATED DRAIN LINE.
- 11) SITE STAIRS (STACKED RR TIES WITH DECOMPOSED GRANITE INFILL) : 40 SF

TOTAL AREA OF IMPERVIOUS SURFACE: 3852 SF
% OF TOTAL SITE AREA: (3852 SF / 8346 SF) : 46.1%

REDUCTION OF IMPERVIOUS SURFACE FROM EXISTING CONDITION:
(4822 SF - 3852 SF) : 970 SF

PORTIONS OF SITE PLAN WITH NO HATCHING REPRESENT PLANTED GROUND-
FULLY PERMEABLE SURFACES.



1 SITE DRAINAGE - PROPOSED CONDITION

- 1) ASPHALT PAVEMENT: 2705 SF
- 2) CONCRETE WALKWAY/PATIO: 555 SF
- 3) HOUSE FOOTPRINT: 1601 SF
- 4) SPLASH BLOCKS BELOW GUTTER DOWNPIPE.

TOTAL AREA OF IMPERVIOUS SURFACE: 4861 SF
% OF TOTAL SITE AREA: (4861 SF / 8346 SF) : 58.2%

PORTIONS OF SITE PLAN WITH NO HATCHING REPRESENT PLANTED GROUND-
FULLY PERMEABLE SURFACES.

1 SITE DRAINAGE - EXISTING CONDITION

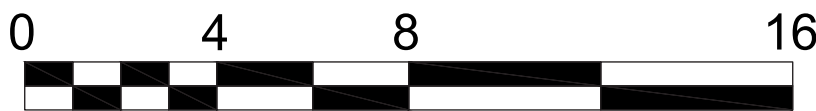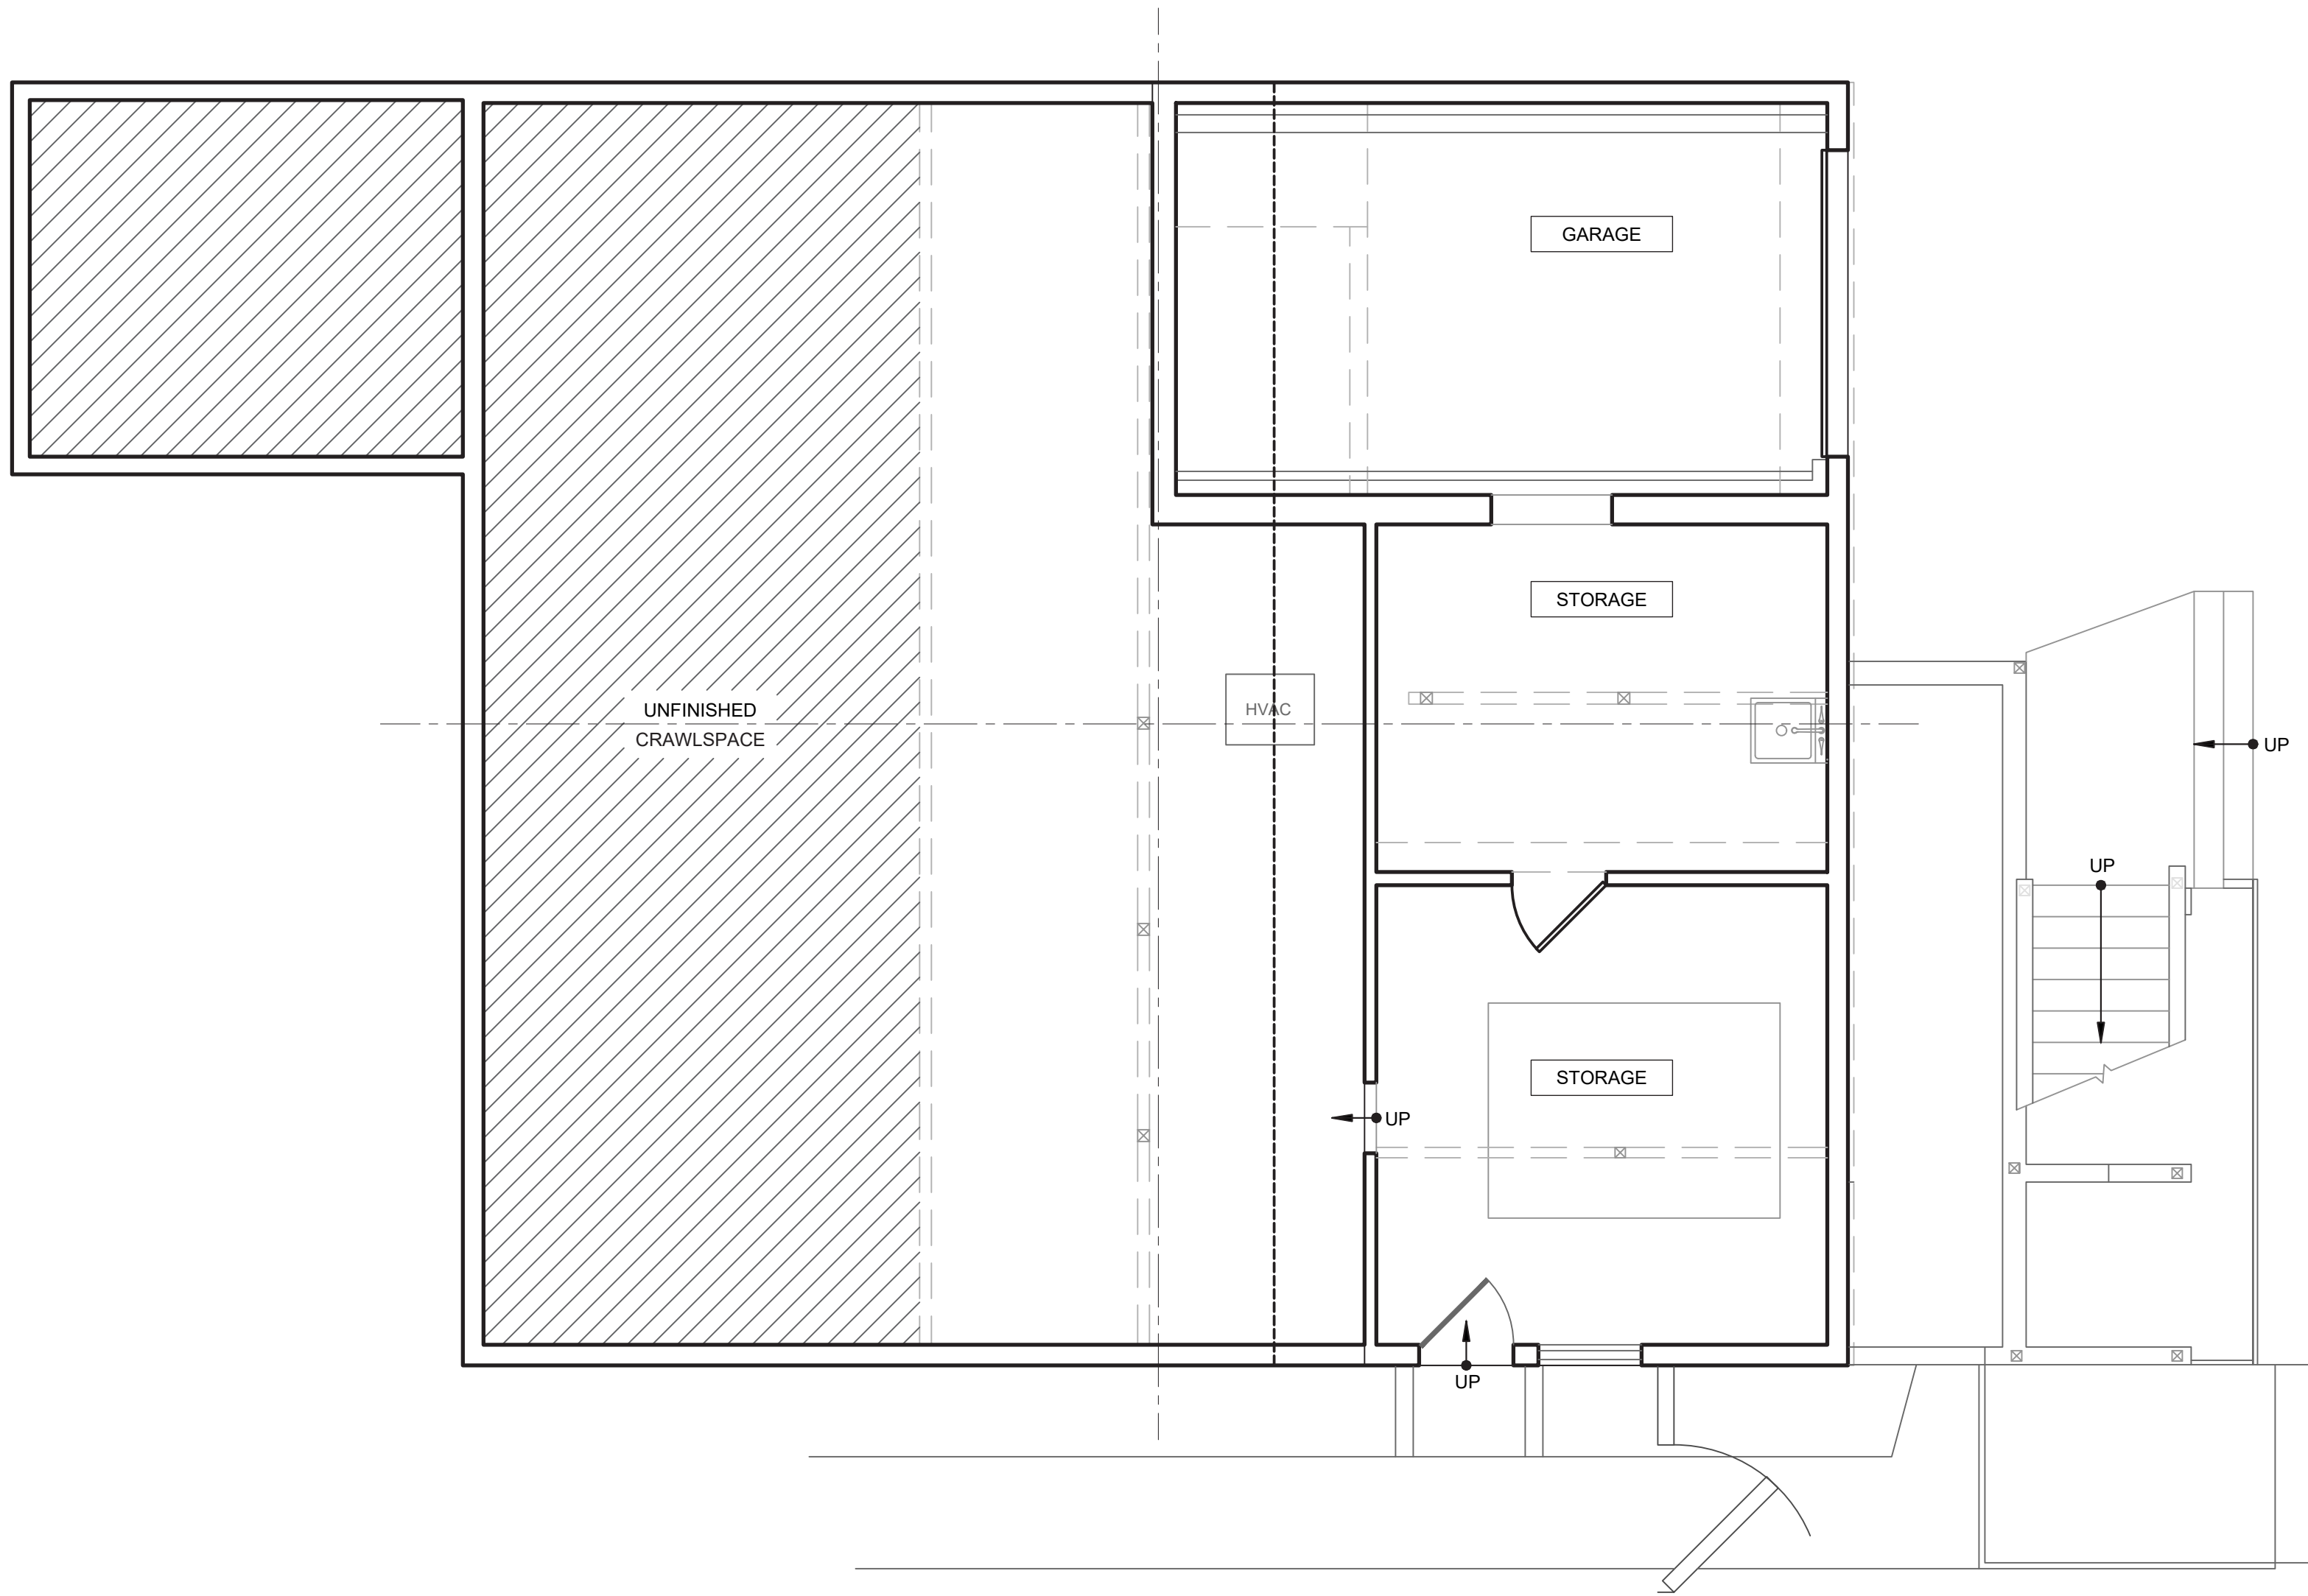



AREA OF MAIN FLOOR (BEFORE DEMOLITION) : 571.1 SF

WINDOW SCHEDULE

MARK	SIZE (RO)		LOCATION	DESCRIPTION	TEMPERED	QTY	U-FACTOR	SHGC
	WIDTH	HEIGHT						
W001	7'-6"	7'-8"	PROJECT ROOM	ANDERSEN E-SERIES	Y	1	.30	.25
W002	1'-3"	4'-8"	BATH	ANDERSEN E-SERIES	Y	1	.30	.25
W003	4'-6"	4'-8"	BEDROOM #4	ANDERSEN E-SERIES	N	1	.30	.25

DOOR SCHEDULE


MARK	SIZE (RO)		LOCATION	DESCRIPTION	RATING	QTY	U-FACTOR	HARDWARE GROUP
	WIDTH	HEIGHT						
D001	10'-0"	7'-0"	GARAGE	OVERHEAD DOOR	-	1	.06	-
D002	1'-3"	7'-0"	MUDROOM	STEEL DOOR & FRAME	20-MIN	1	-	01
D003	3'-4"	7'-0"	STORAGE	STEEL DOOR & FRAME	20-MIN	1	-	02
D004	3'-4"	7'-0"	MECHANICAL	STEEL DOOR & FRAME	20-MIN	1	-	03
D005	3'-4"	7'-0"	LAUNDRY	SOLID WOOD	-	1	-	03
D006	3'-4"	8'-0"	PROJECT ROOM	ANDERSEN E-SERIES	-	1	.25	04
D007	3'-0"	7'-0"	BATH #4	SOLID WOOD	-	1	-	05
D008	3'-0"	7'-0"	BEDROOM #4	SOLID WOOD	-	1	-	05


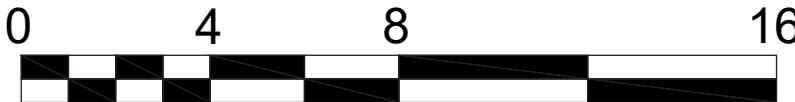
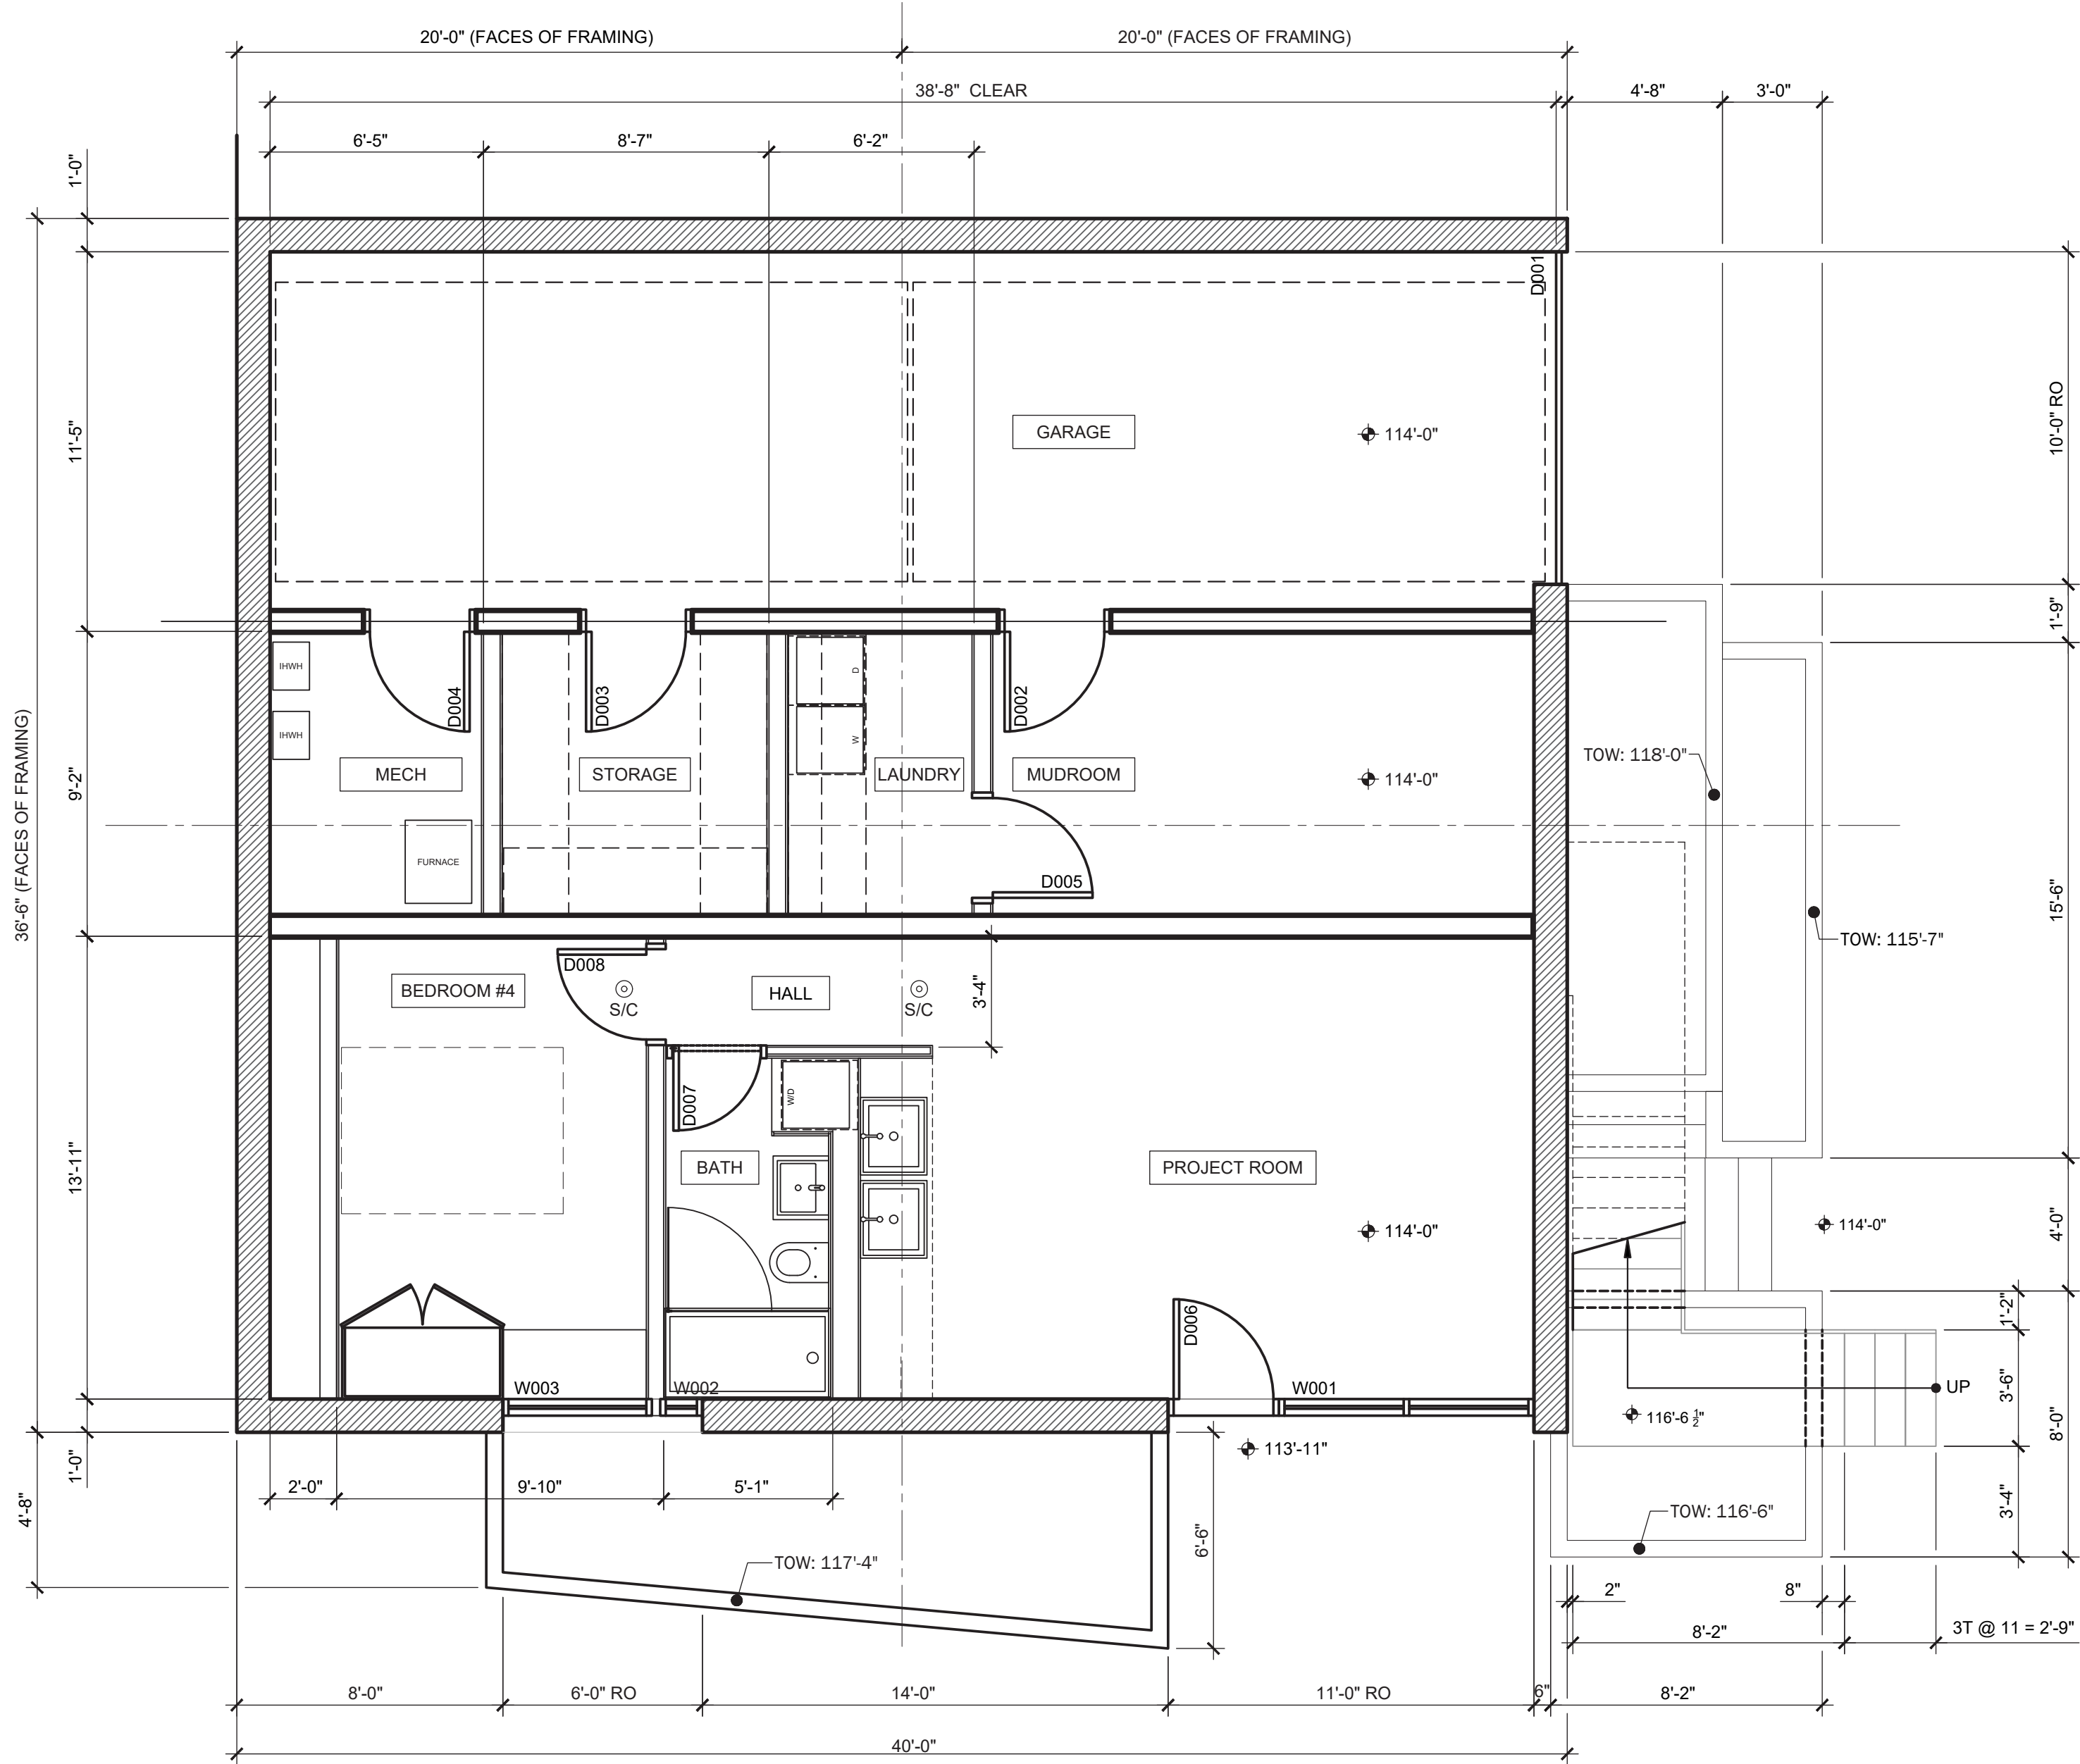


AREA OF LOWER FLOOR : 1449.8 SF


KEY
①
S/C
COMBINED CARBON MONOXIDE/SMOKE ALARM PER REQUIREMENTS OF CALIFORNIA RESIDENTIAL CODE, SECTIONS R314 AND R315. MOUNTED ON CEILING, UNO.

NOTE:
DIMENSIONS ARE TO FACE OF FRAMING, UNO.

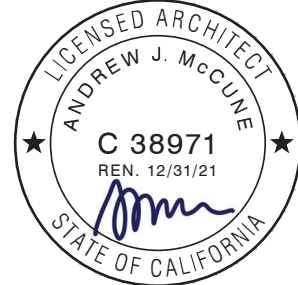


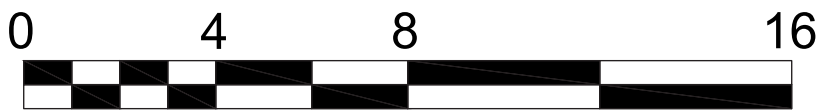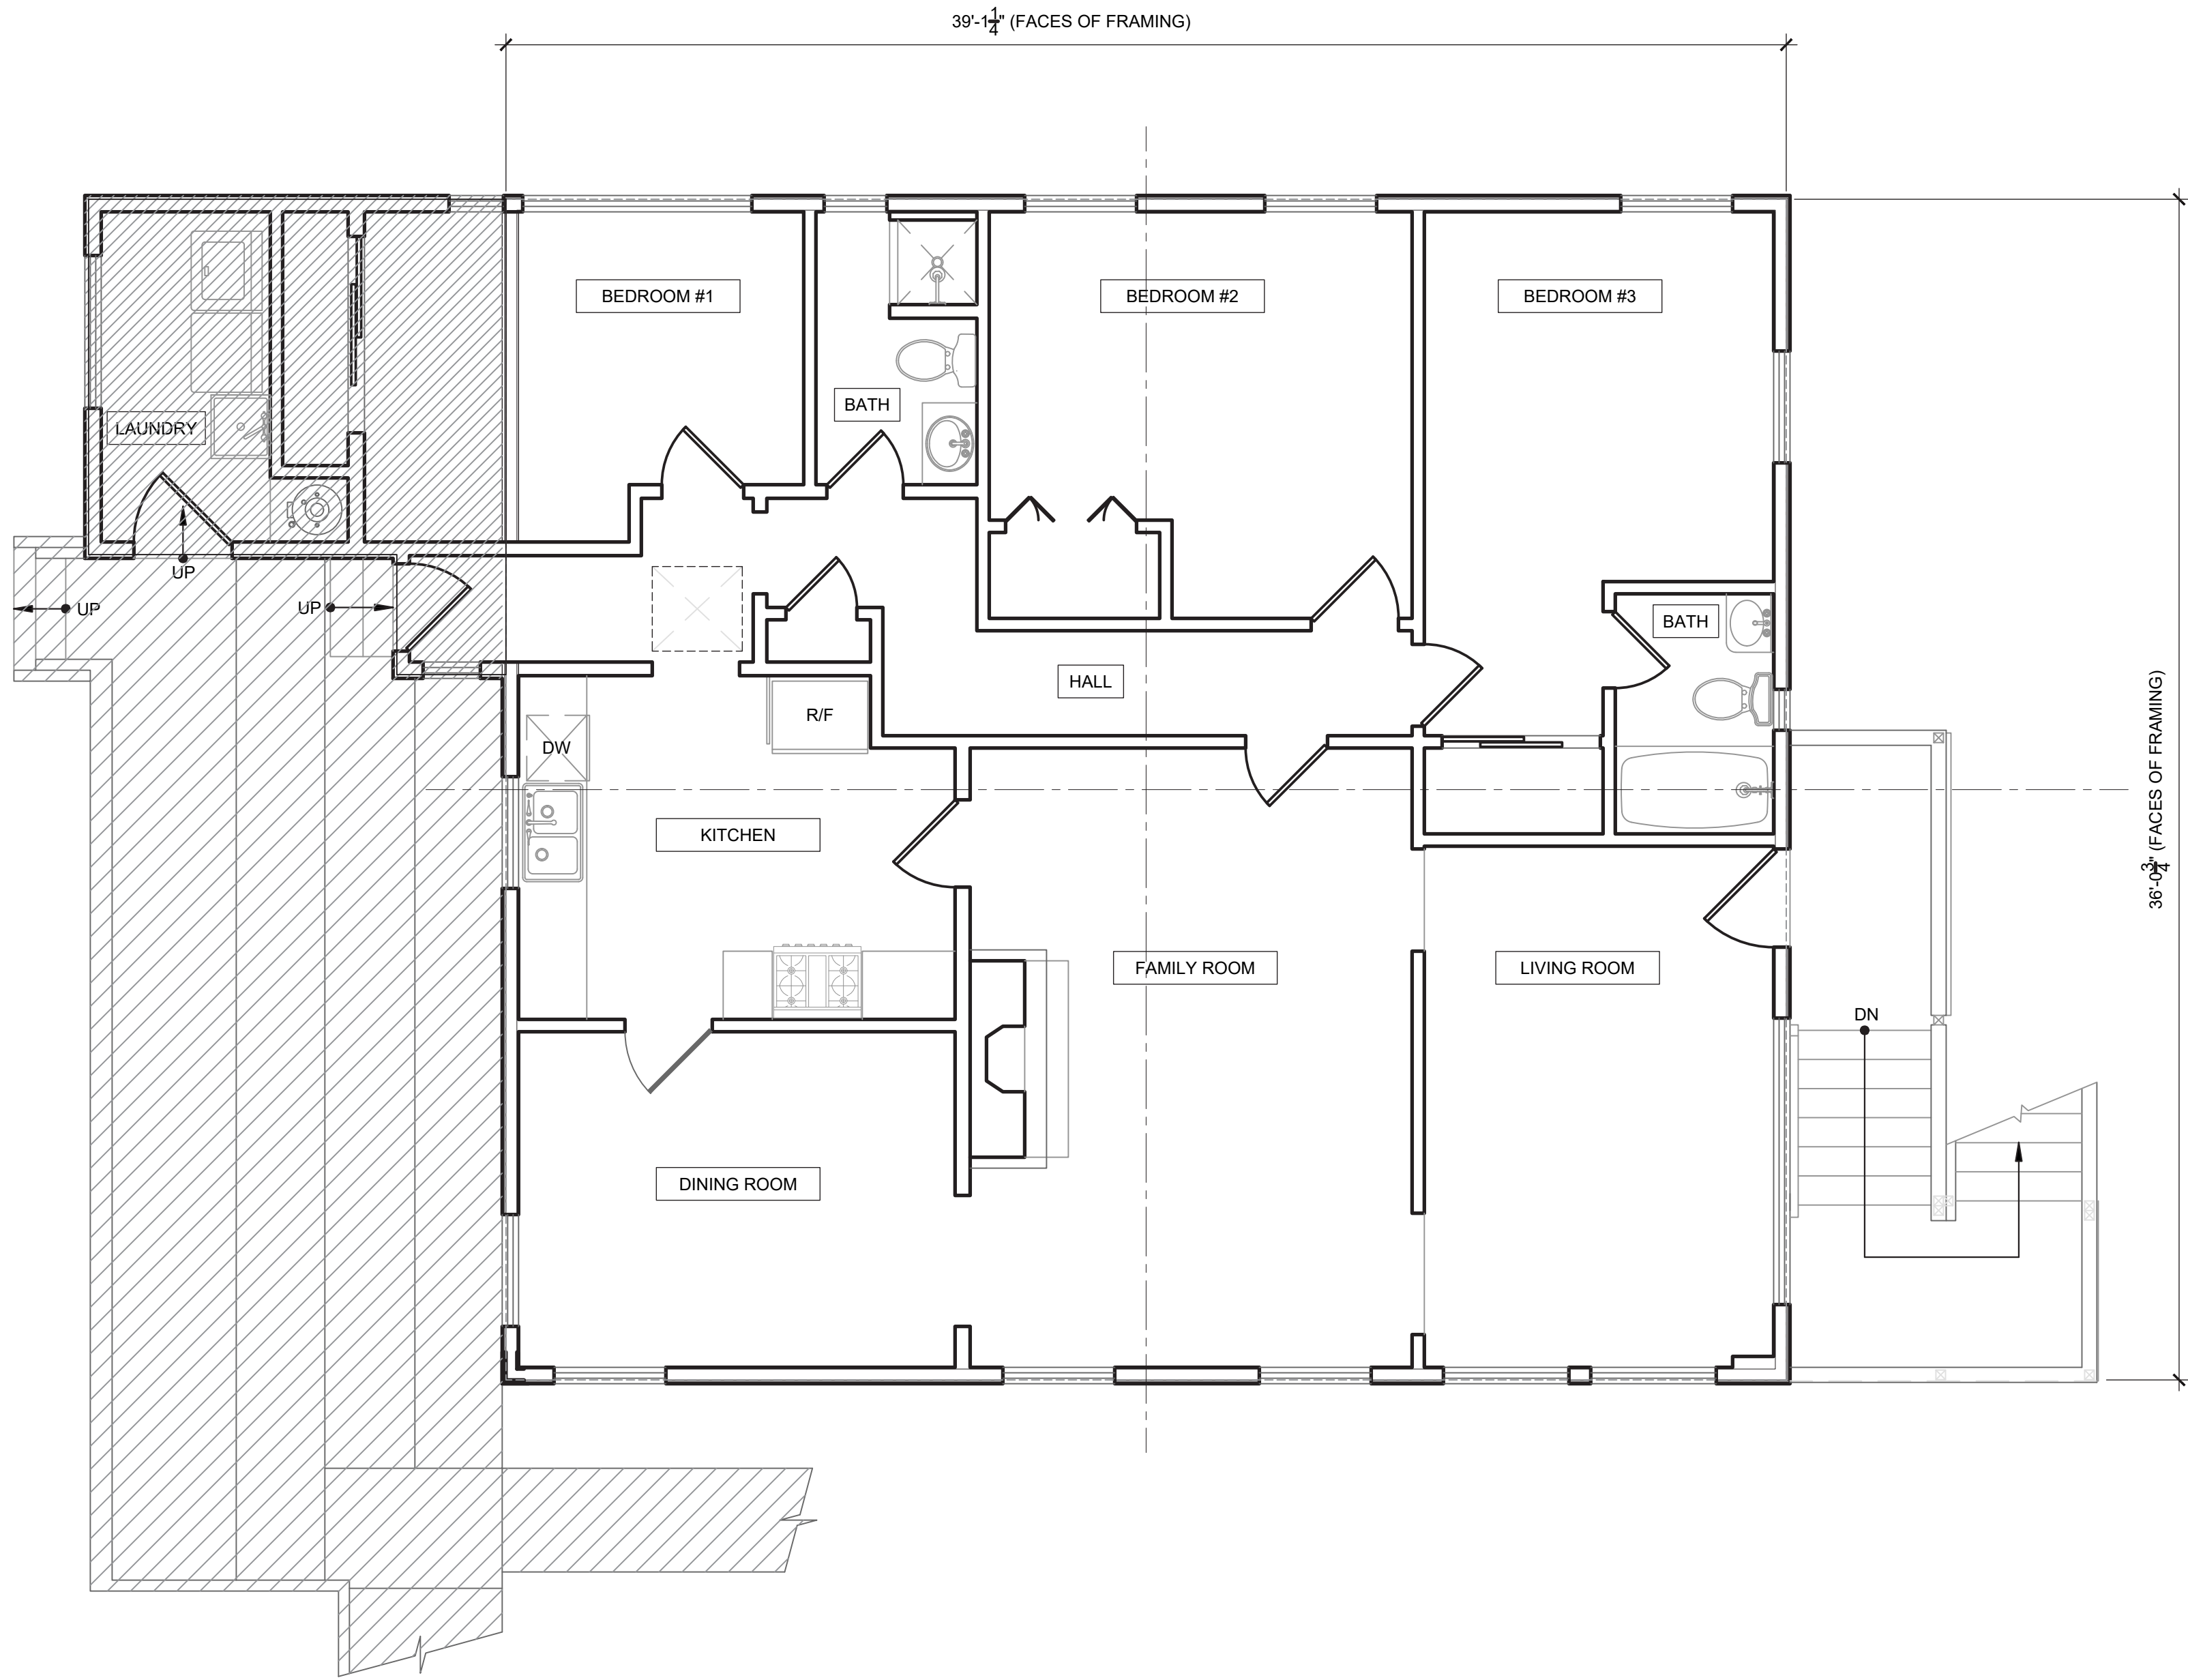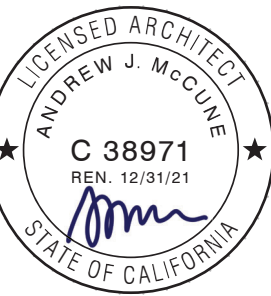

AREA OF MAIN FLOOR (BEFORE DEMOLITION) : 1560.9 SF
AREA OF MAIN FLOOR (REMAINING AFTER DEMOLITION) : 1410.3 SF

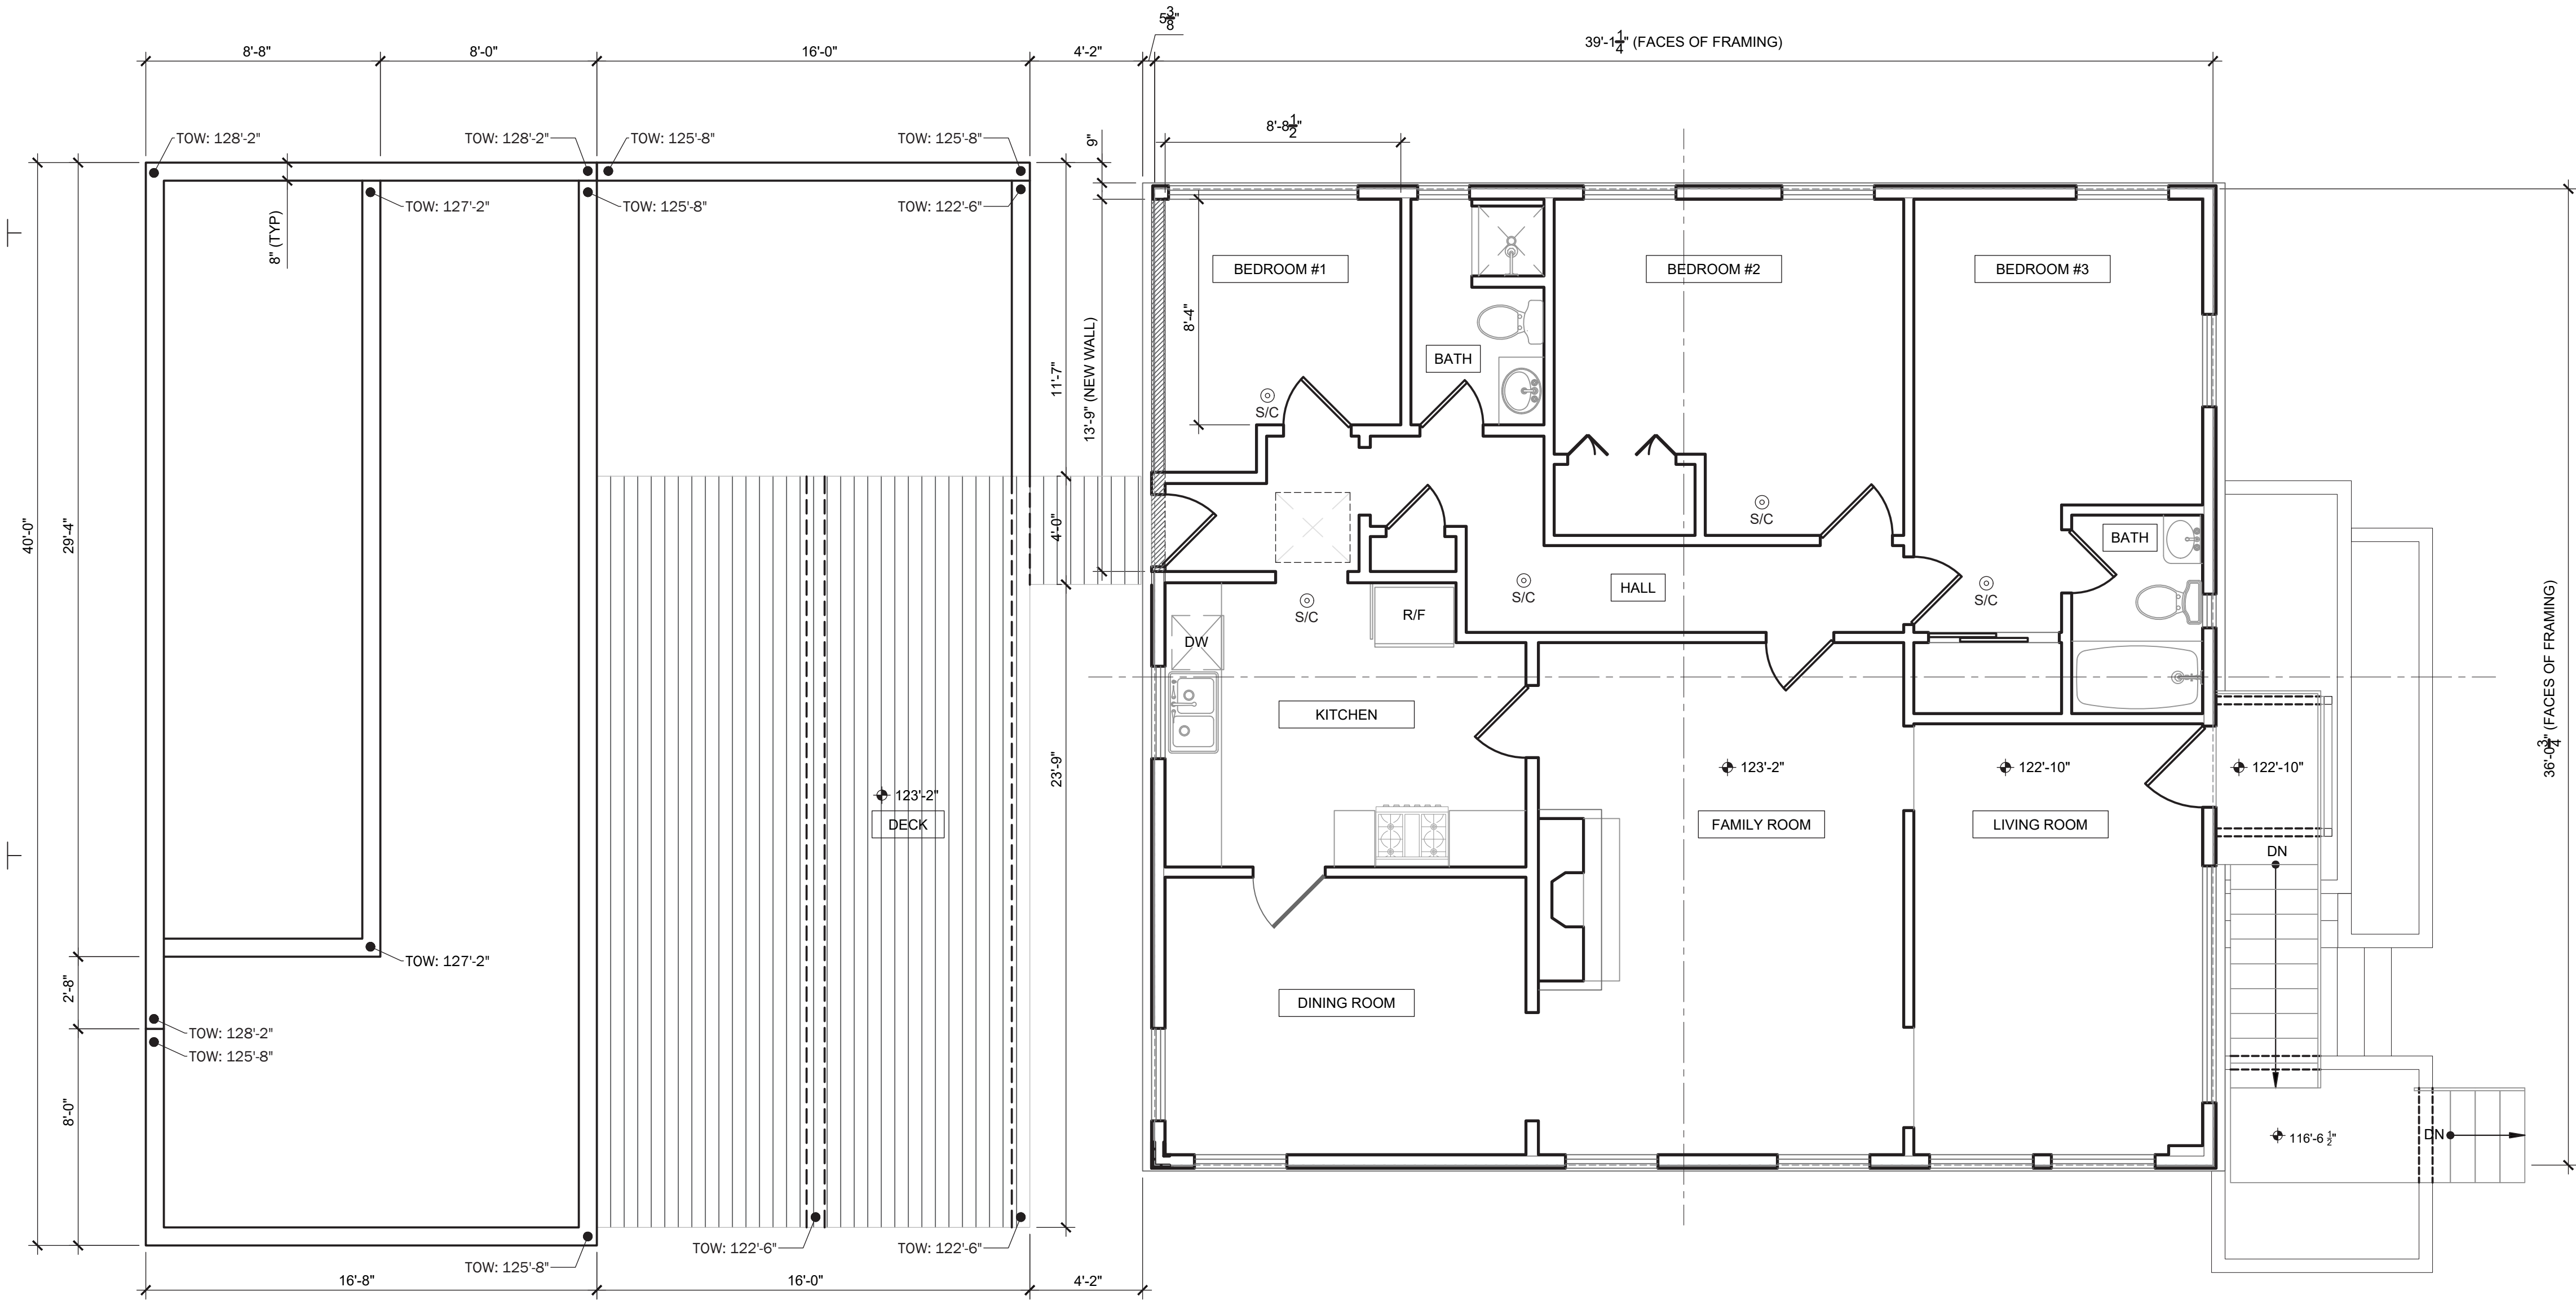


NORTH

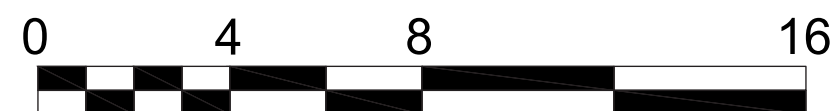

NOTE:
DIMENSIONS ARE TO FACE OF FRAMING, UNO.

AREA OF MAIN FLOOR (REMAINING AFTER DEMOLITION) : 1410.3 SF

KEY
1
S/C
COMBINED CARBON MONOXIDE/SMOKE ALARM PER REQUIREMENTS OF CALIFORNIA RESIDENTIAL CODE, SECTIONS R314 AND R315. MOUNTED ON CEILING, UNO.

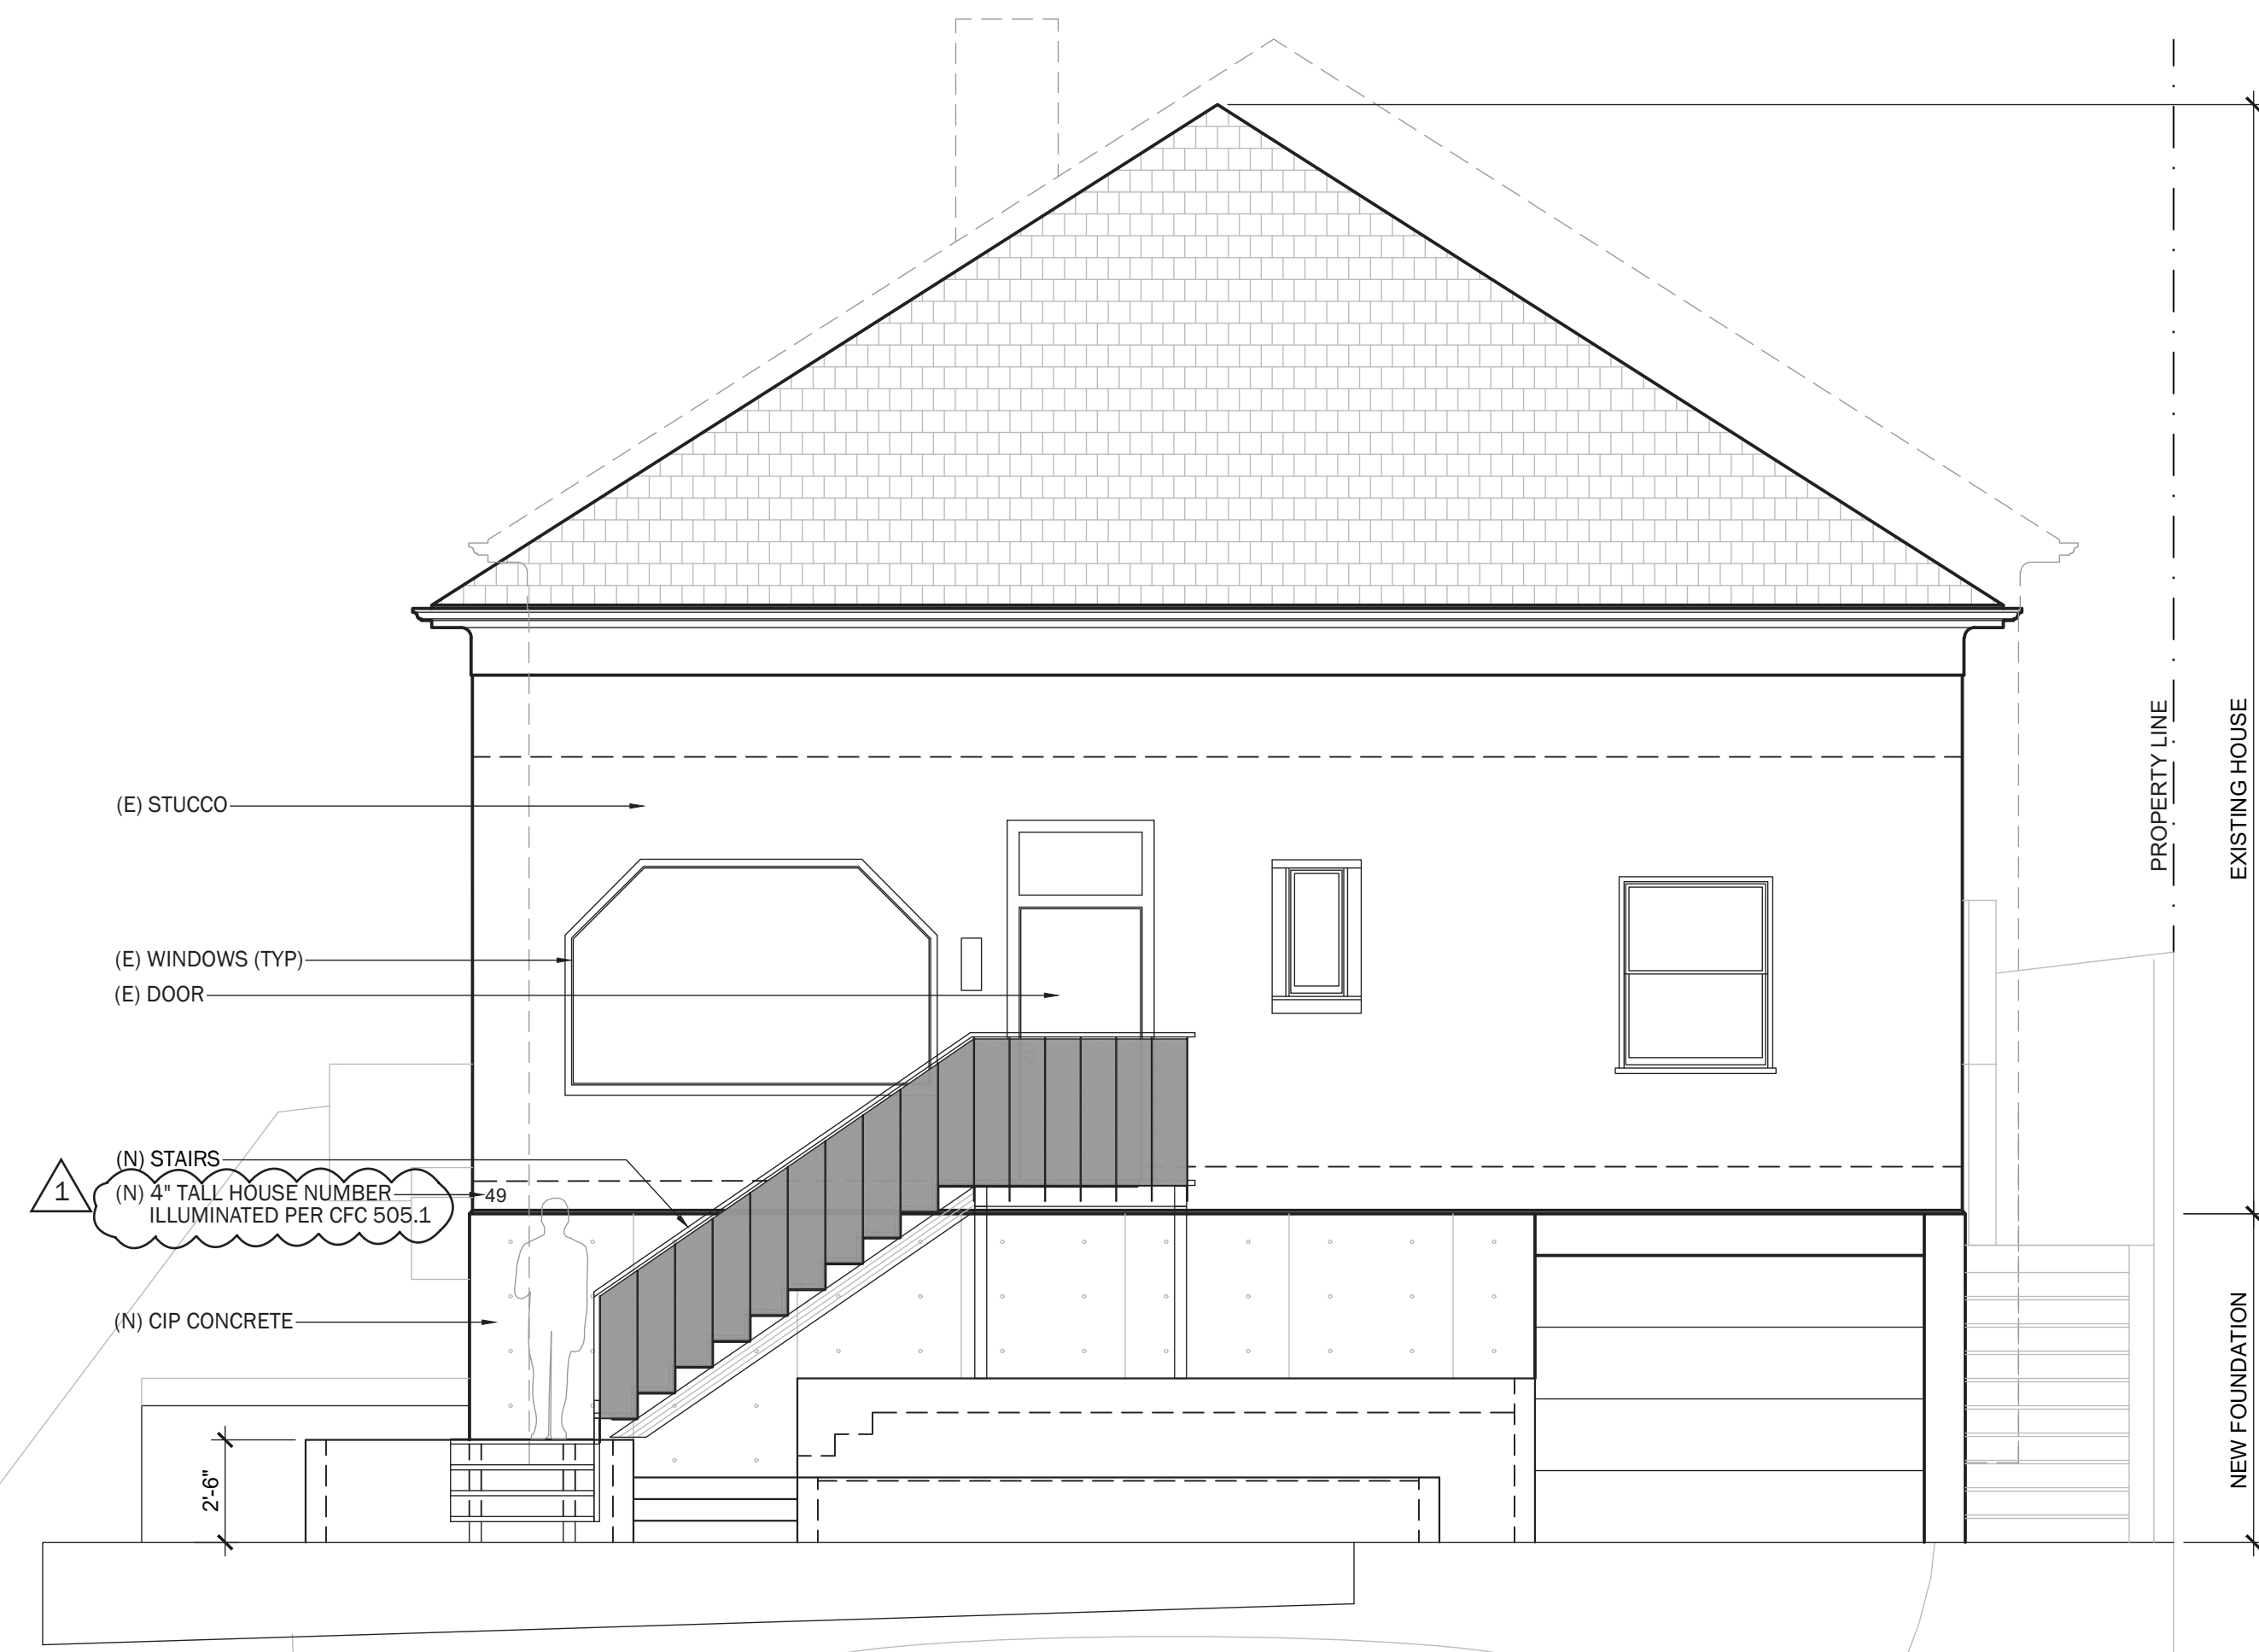150'-8"
RIDGE138'-2"
TO PLATE134'-9"
FF ATTIC124'-9"
FF MAIN FLOOR124'-5"
FF MAIN FLOOR116'-6"
FF SLAB115'-10"
FF GARAGE149'-1 1/2"
MAX. HEIGHT (EXISTING)149'-1"
RIDGE (NEW)148'-0"
MAX. HEIGHT (NEW)136'-7"
TO PLATE133'-2"
FF ATTIC128'-2"
TO WALL123'-2"
FF MAIN FLOOR122'-10"
FF MAIN FLOOR117'-2"
TO ENTRY LANDING114'-0"
FF GARAGE1
2 EAST ELEVATION (FRONT) - EXISTING CONDITION1
1 EAST ELEVATION (FRONT) - PROPOSED CONDITION

150'-8"
RIDGE

138'-2"
TO PLATE

134'-9"
FF ATTIC

124'-9"
FF MAIN FLOOR

124'-5"
FF MAIN FLOOR

116'-6"
FF SLAB

115'-10"
FF GARAGE

RIDGE PEAK (EXISTING)

149'-1 1/2"
MAX. HEIGHT (EXISTING)

149'-1"
RIDGE (NEW)

148'-0"
MAX. HEIGHT (NEW)

136'-7"
TO PLATE

133'-2"
FF ATTIC

128'-2"
TO WALL

125'-8"
TO WALL

123'-2"
FF MAIN FLOOR

122'-10"
FF MAIN FLOOR

117'-2"
TO ENTRY LANDING

114'-0"
FF GARAGE

REAR PROPERTY LINE

1 (N) PATCH W/COMPOSITE SHINGLE ROOFING
- MATCH EXISTING

1 (E) COMPOSITE SHINGLE ROOFING
(CLASS 'A' ROOF ASSEMBLY)

(E) STUCCO

(E) WINDOWS (TYP)

(N) SITE/RETAINING WALLS

(N) DECK

(N) CIP CONCRETE

(N) STAIRS

2 SOUTH ELEVATION (SIDE) - EXISTING CONDITION

EXISTING

HIGH POINT: 124'-0"
LOW POINT: 114'-3"
AVG. GRADE: 119'-1 1/2"
MAX. HEIGHT: 149'-1 1/2"

NEW

HIGH POINT: 122'-0"
LOW POINT: 114'-0"
AVG. GRADE: 118'-0"
MAX. HEIGHT: 148'-0"

1 SOUTH ELEVATION (SIDE) - PROPOSED CONDITION

150'-8"
RIDGE

138'-2"
TO PLATE

134'-9"
FF ATTIC

124'-9"
FF MAIN FLOOR
124'-5"
FF MAIN FLOOR

115'-10"
FF GARAGE


150'-8"
RIDGE (EXISTING)
149'-1 1/2"
MAX. HEIGHT (EXISTING)
149'-1"
RIDGE (NEW)
148'-0"
MAX. HEIGHT (NEW)
PER SACMC 10-3.404

136'-7"
TO PLATE


133'-2"
FF ATTIC

123'-2"
FF MAIN FLOOR & DECK

114'-0"
FF GARAGE

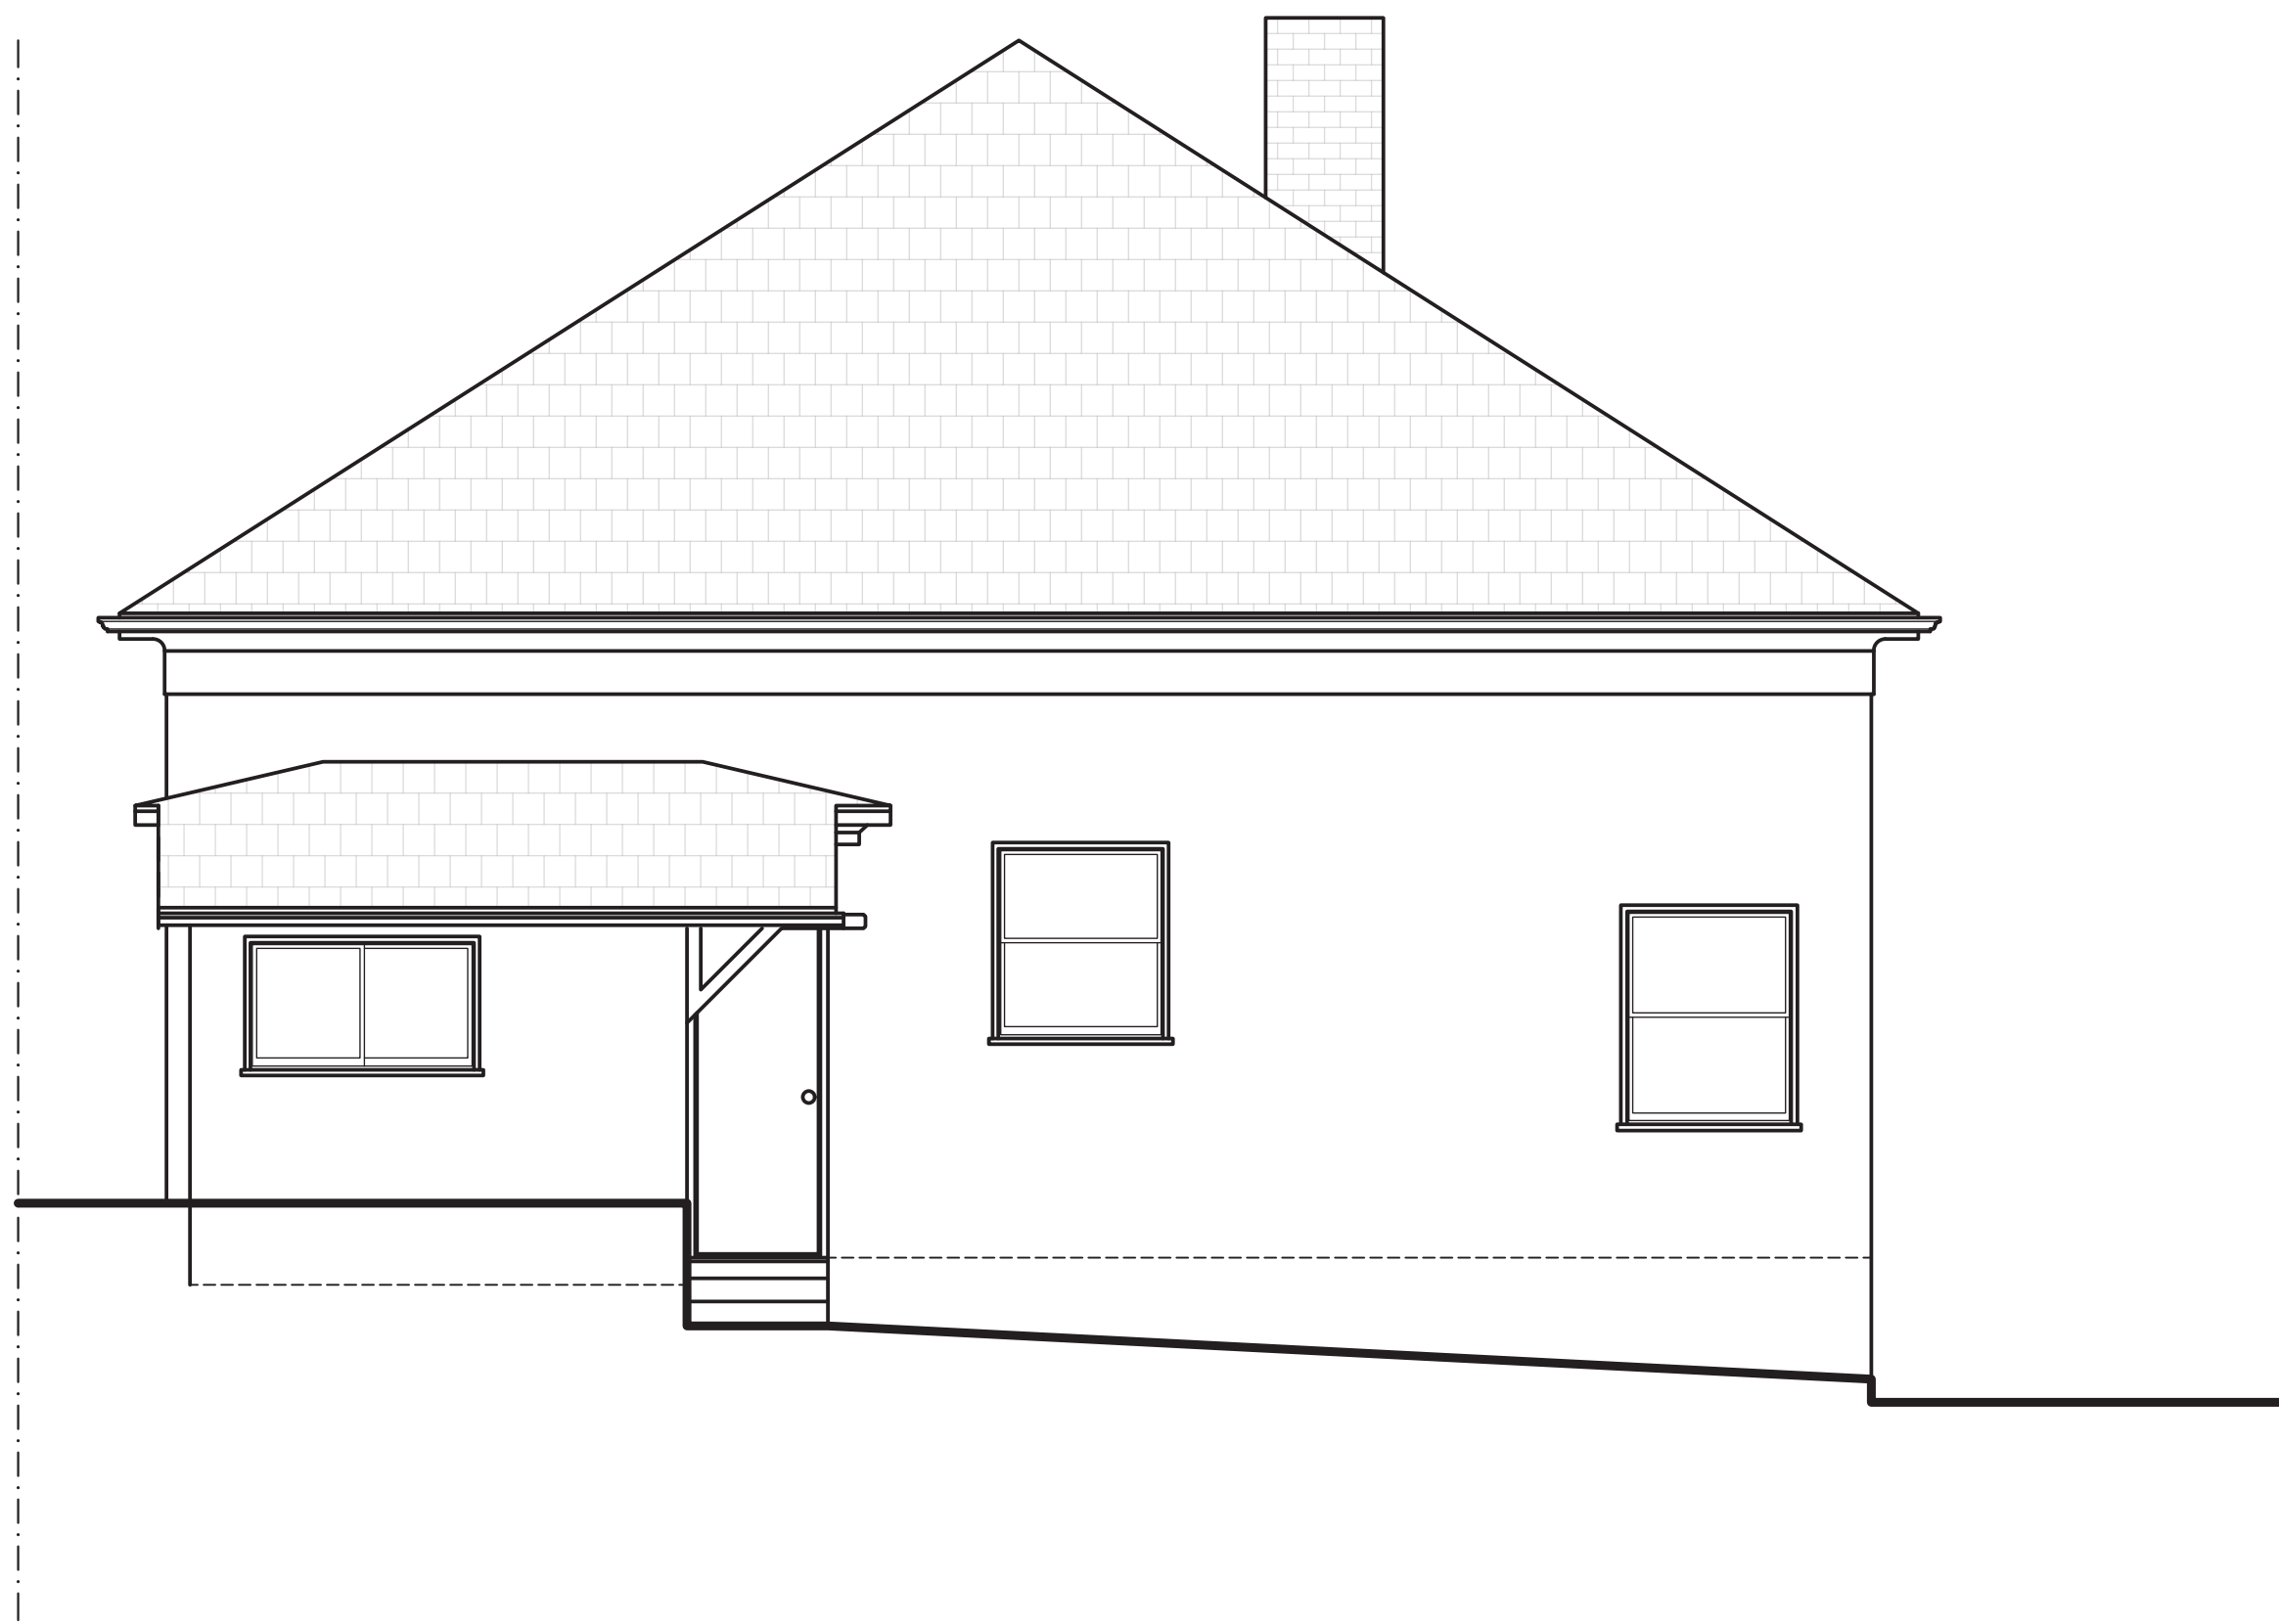

1
2 WEST ELEVATION (REAR) - EXISTING CONDITION

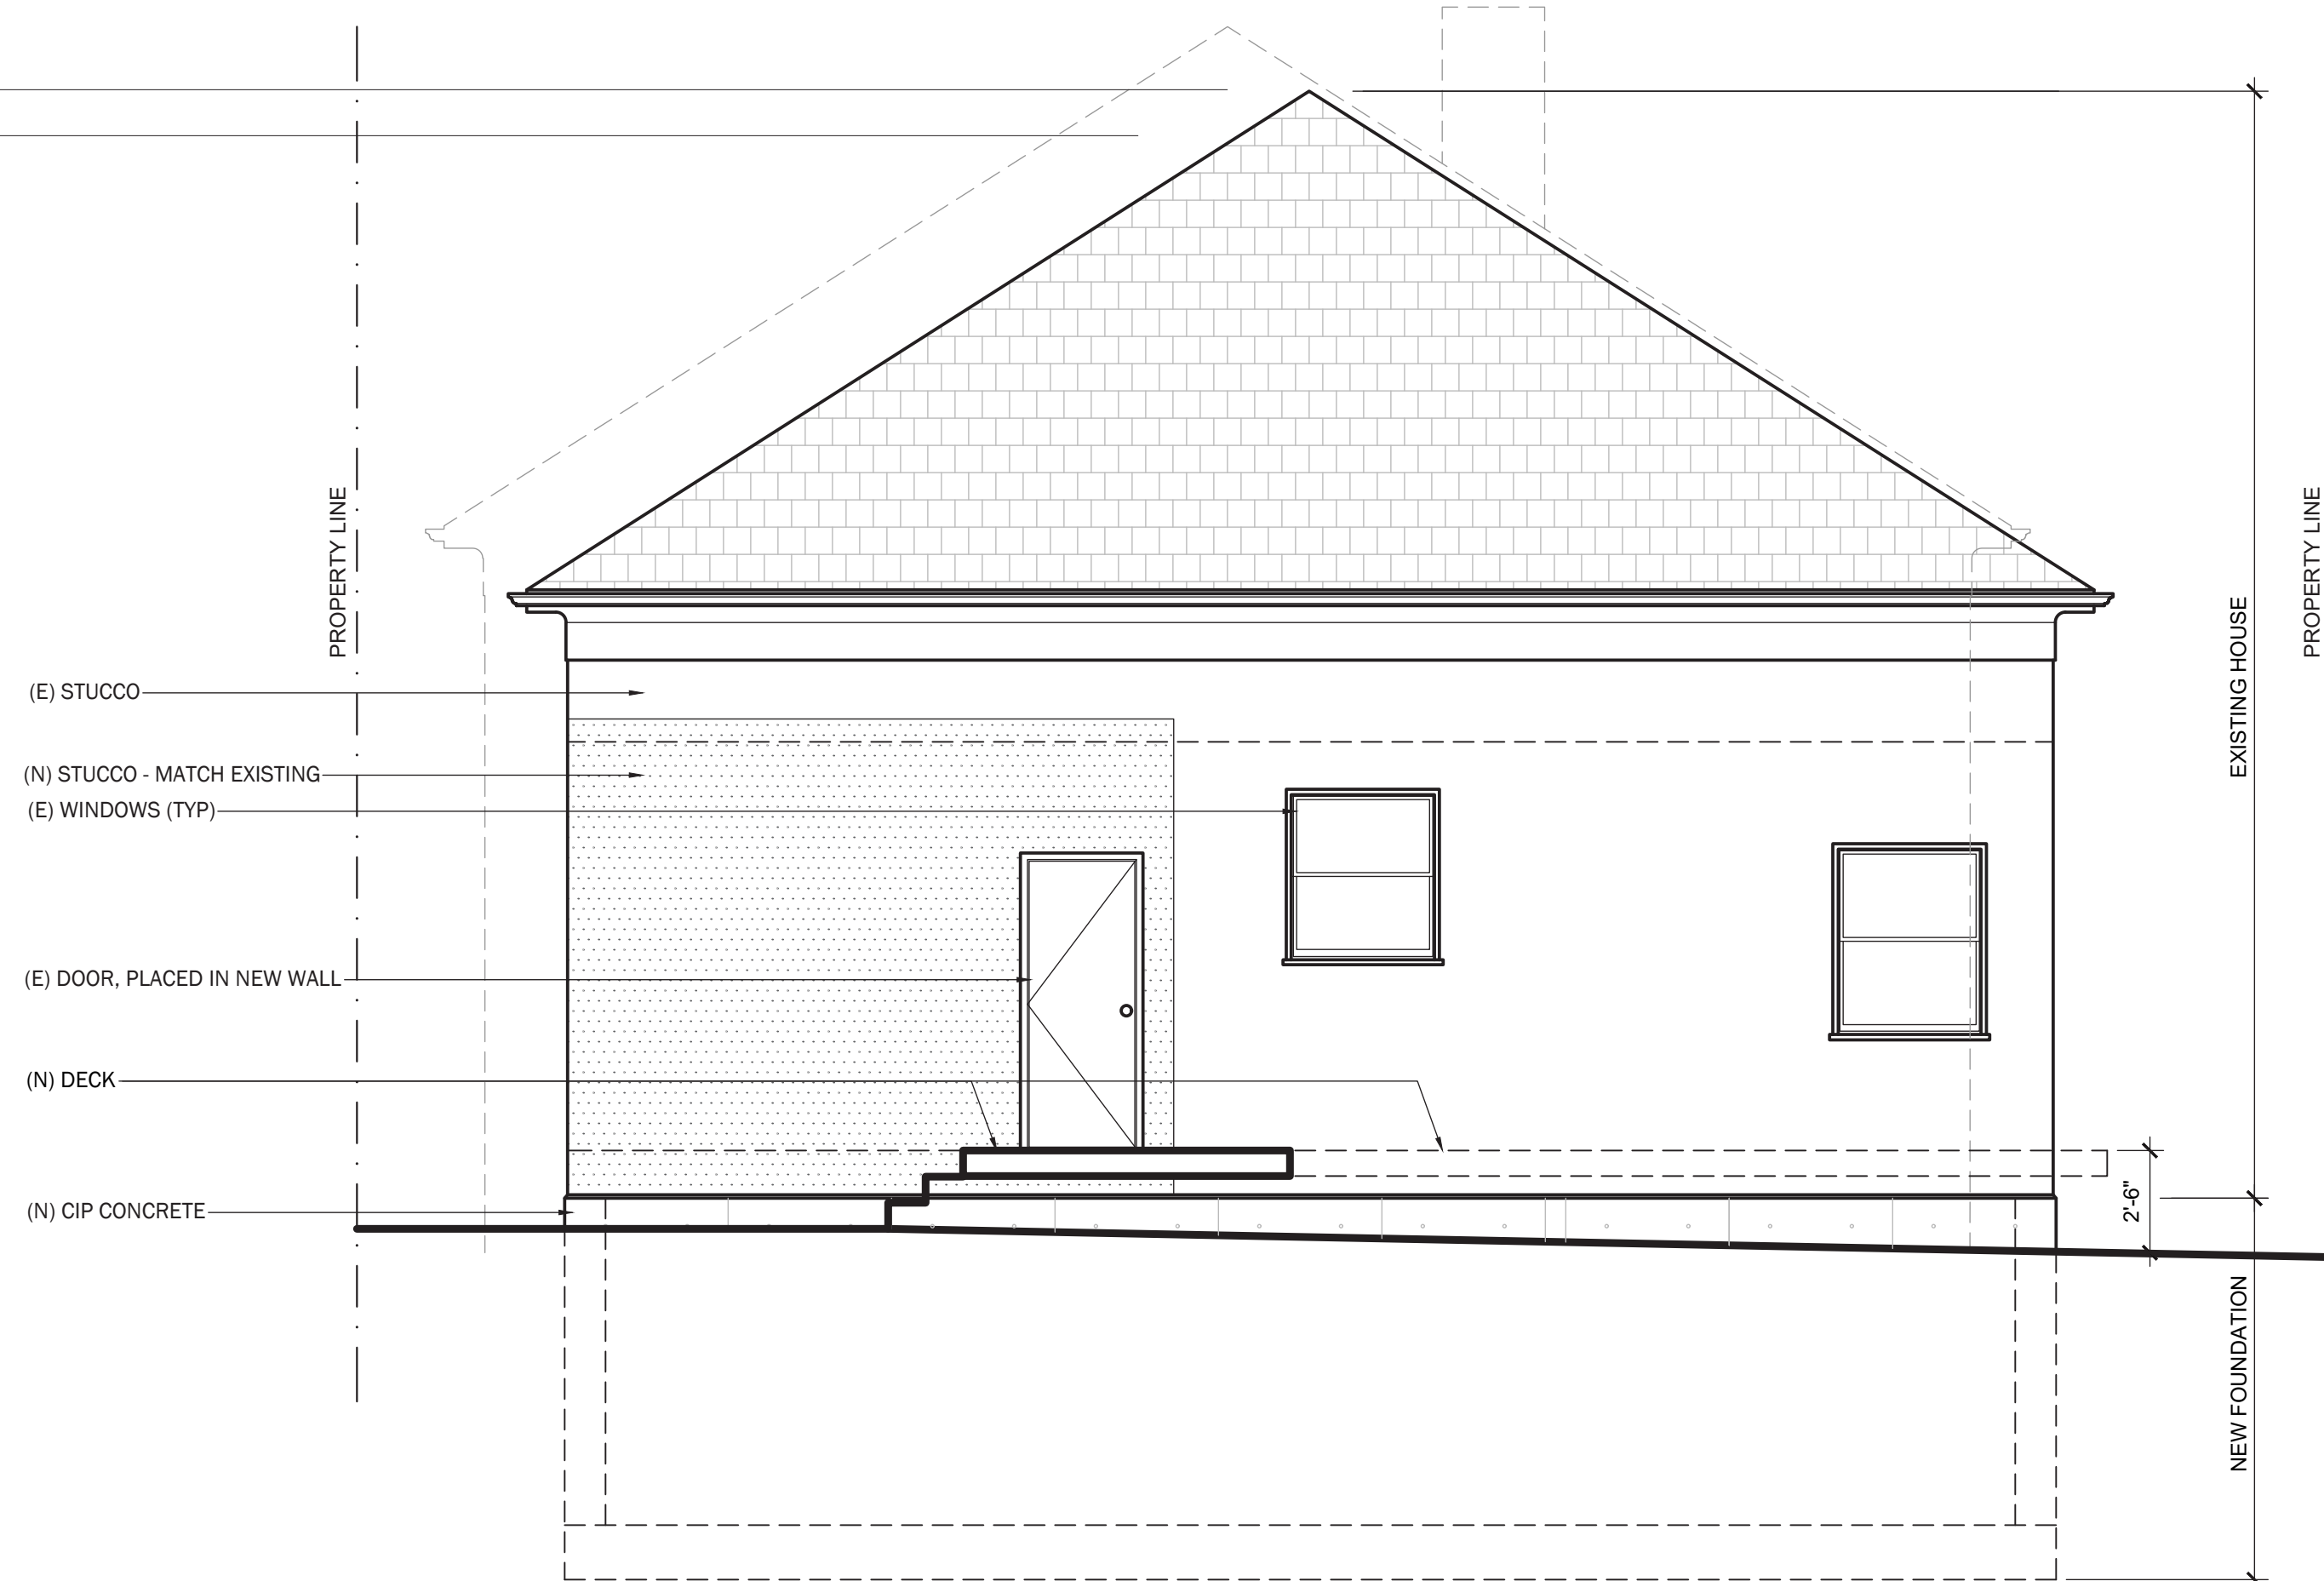

1
1 WEST ELEVATION (REAR) - PROPOSED CONDITION

- 150'-8" RIDGE
- 138'-2" TO PLATE
- 134'-9" FF ATTIC
- 124'-9" FF MAIN FLOOR
- 124'-5" FF MAIN FLOOR
- 115'-10" FF GARAGE

- 150'-8" RIDGE (EXISTING)
- 149'-1 1/2" MAX. HEIGHT (EXISTING)
- 149'-1" RIDGE (NEW)
- 148'-0" MAX. HEIGHT (NEW) PER SACMC 10-3.404

- 136'-7" TO PLATE
- 133'-2" FF ATTIC
- 129'-8" TO WALL
- 125'-8" TO WALL
- 123'-2" FF MAIN FLOOR
- 122'-10" FF MAIN FLOOR
- 117'-2" TO ENTRY LANDING
- 114'-0" FF GARAGE
- 113'-9" TO WALL

(E) COMPOSITE SHINGLE ROOFING

(E) STUCCO

(E) WINDOWS, TYP

(N) CIP CONCRETE

(N) STAIR & GUARD

(N) CIP CONCRETE SITE WALLS

PROPERTY LINE


2 NORTH ELEVATION (SIDE) - EXISTING CONDITION

1 NORTH ELEVATION (SIDE) - PROPOSED CONDITION

ANDREW
McCUNE
ARCHITECT

PO Box 78115
San Francisco, CA 94110
T (206) 850 8500
www.andrewmccune.com


49 SUNNYSIDE AVE
SAN ANSELMO, CA 94960

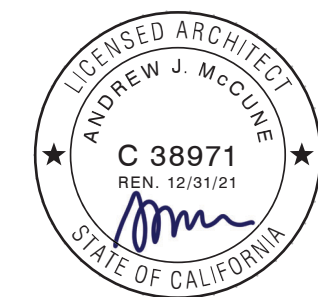


PLAN CHECK - RESPONSE 1

DRAWN BY
AJM
CHECKED BY
AJM
FILE NAME
49Sunnyside_01.dwg
CLIENT
PHILLIPS/McCUNE
PROJECT
49 SUNNYSIDE AVE
JOB NUMBER
2022-001
ISSUANCE
PERMIT
DATE
JULY 01, 2022
SCALE
1/4" = 1'-0"
DRAWING NAME
NORTH
ELEVATIONS

SHEET NUMBER
A2.030

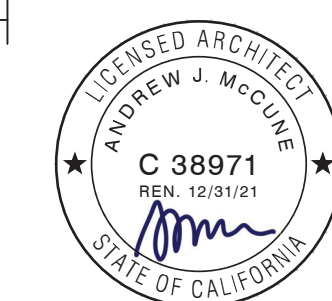

1 SECTION - PROPOSED CONDITION

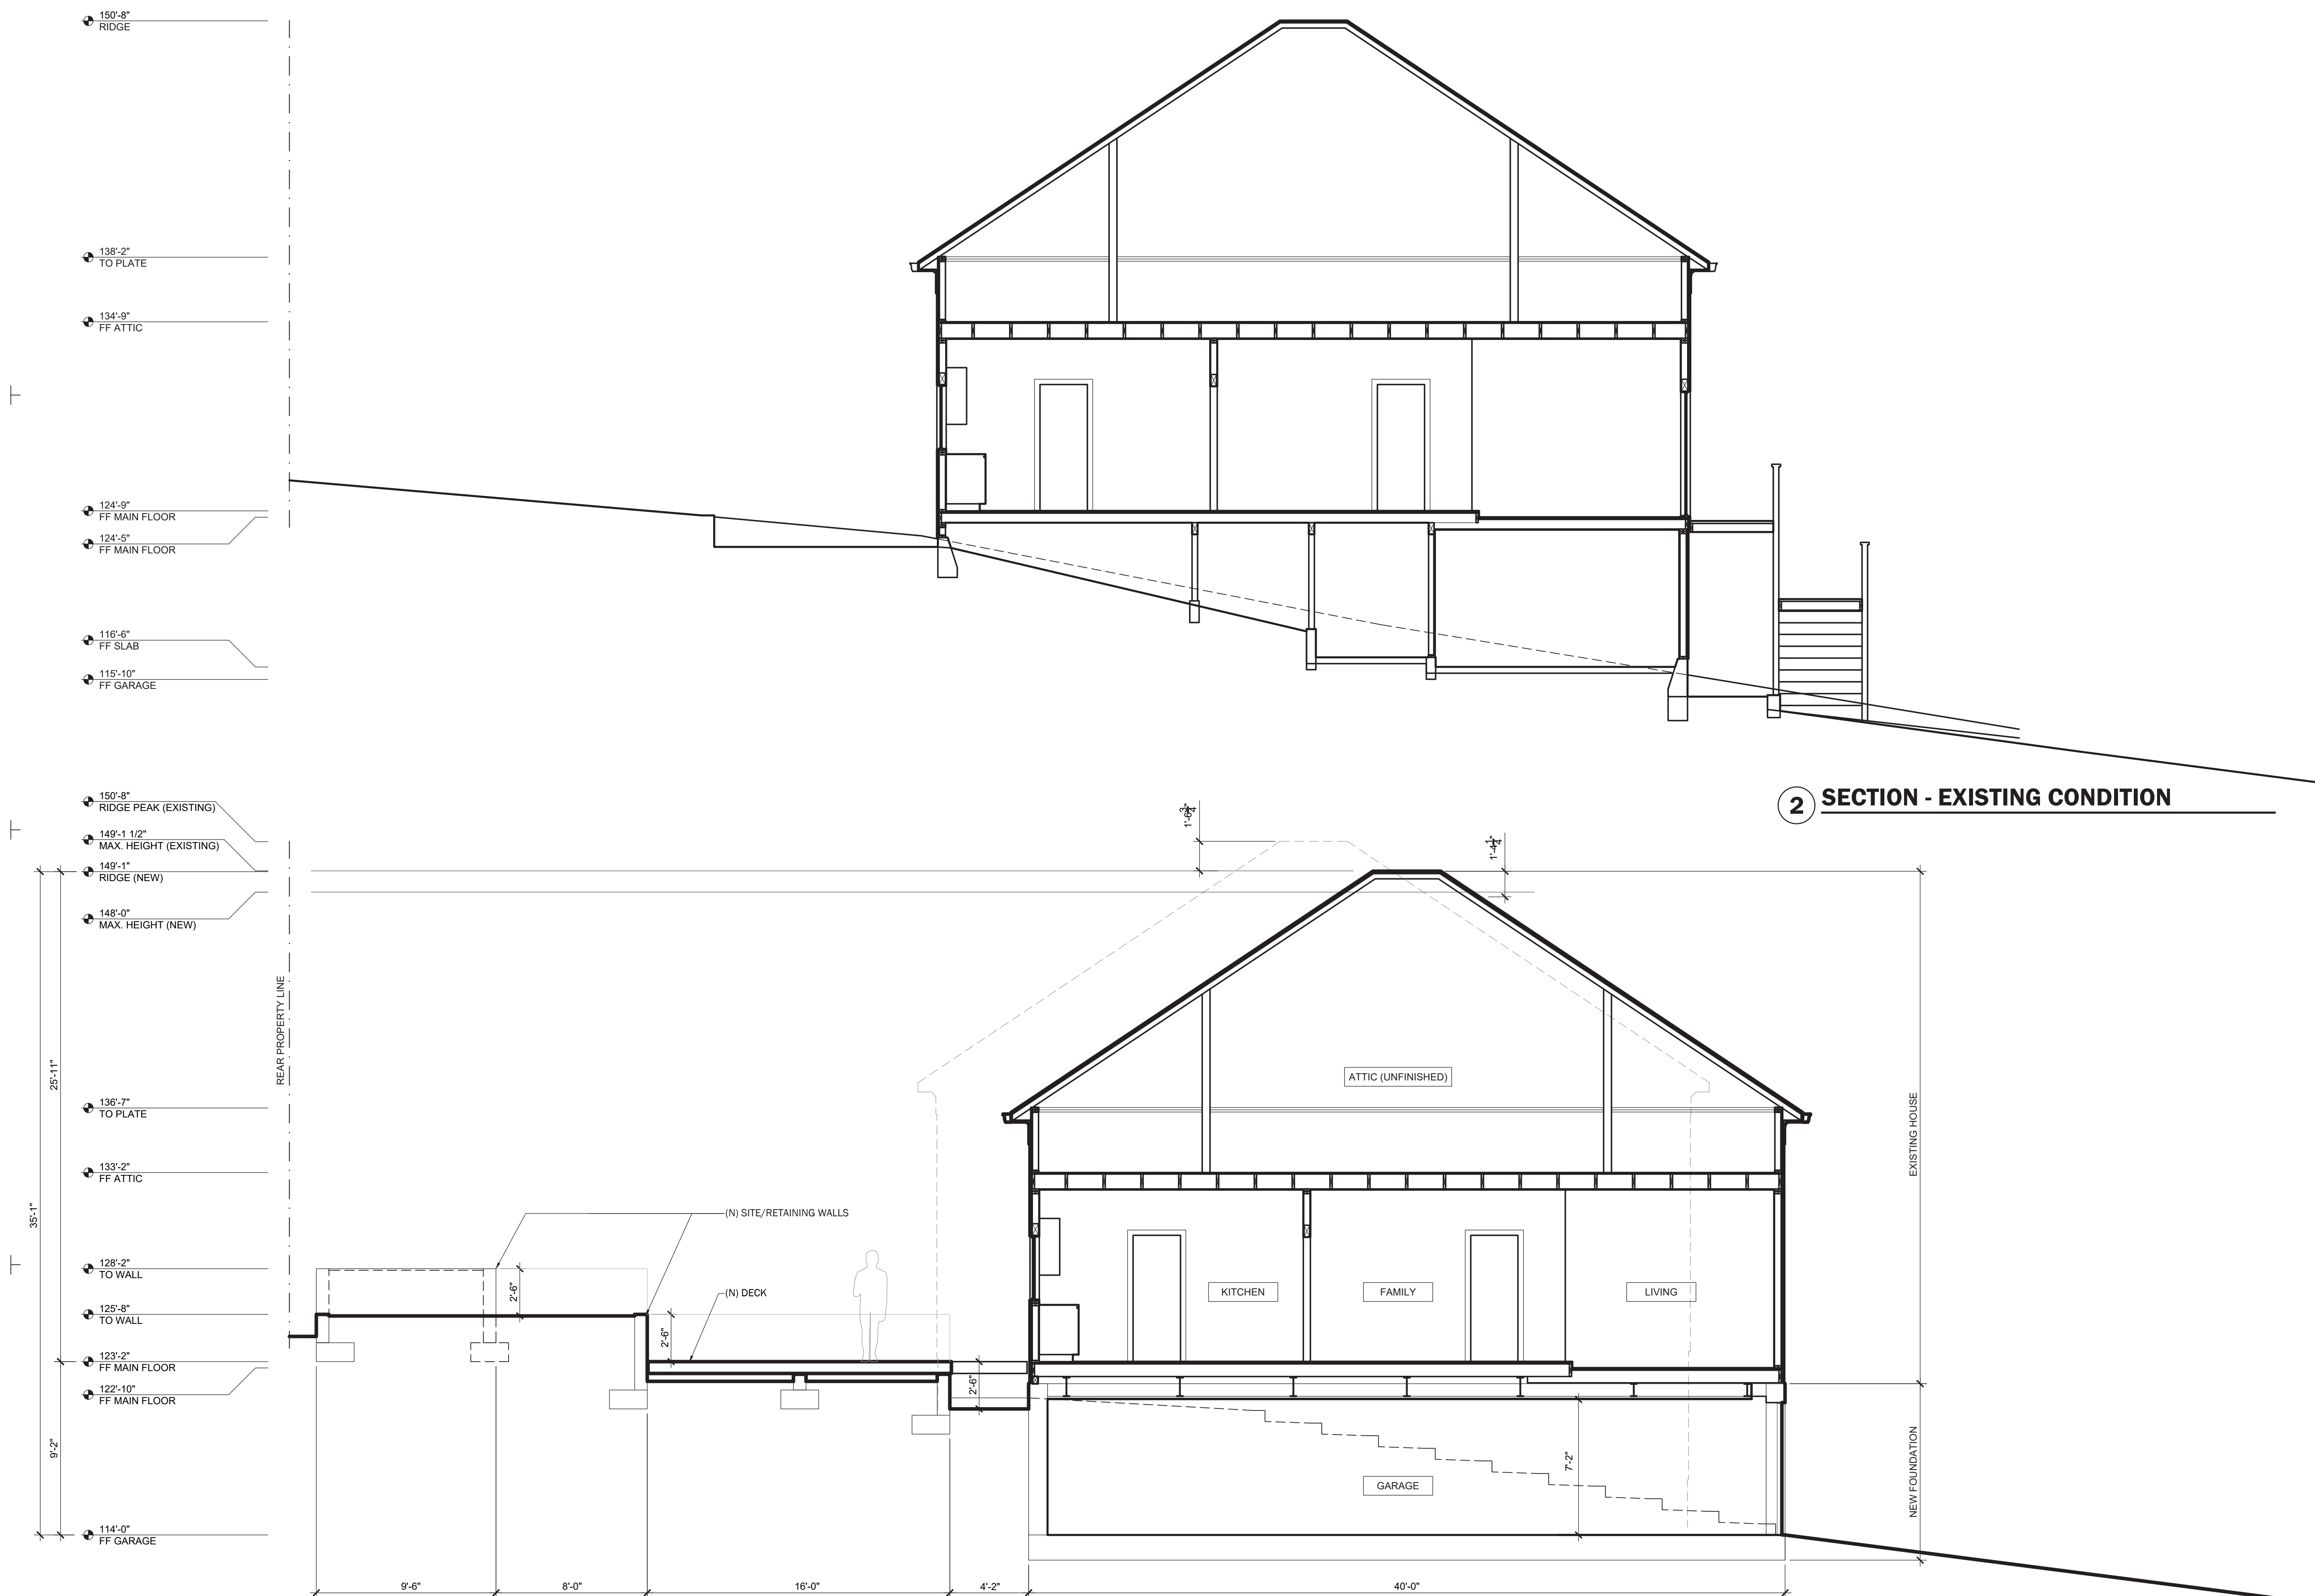



150'-8"
RIDGE

138'-2"
TO PLATE

134'-9"
FF ATTIC

124'-9"
FF MAIN FLOOR

124'-5"
FF MAIN FLOOR

116'-6"
FF SLAB

115'-10"
FF GARAGE

150'-8"
RIDGE PEAK (EXISTING)

149'-1 1/2"
MAX. HEIGHT (EXISTING)

149'-1"
RIDGE (NEW)

148'-0"
MAX. HEIGHT (NEW)

25'-11"

136'-7"
TO PLATE

133'-2"
FF ATTIC

128'-2"
TO WALL

125'-8"
TO WALL

123'-2"
FF MAIN FLOOR

122'-10"
FF MAIN FLOOR


35'-4"

9'-2"


114'-0"
FF GARAGE




2 SECTION - EXISTING CONDITION

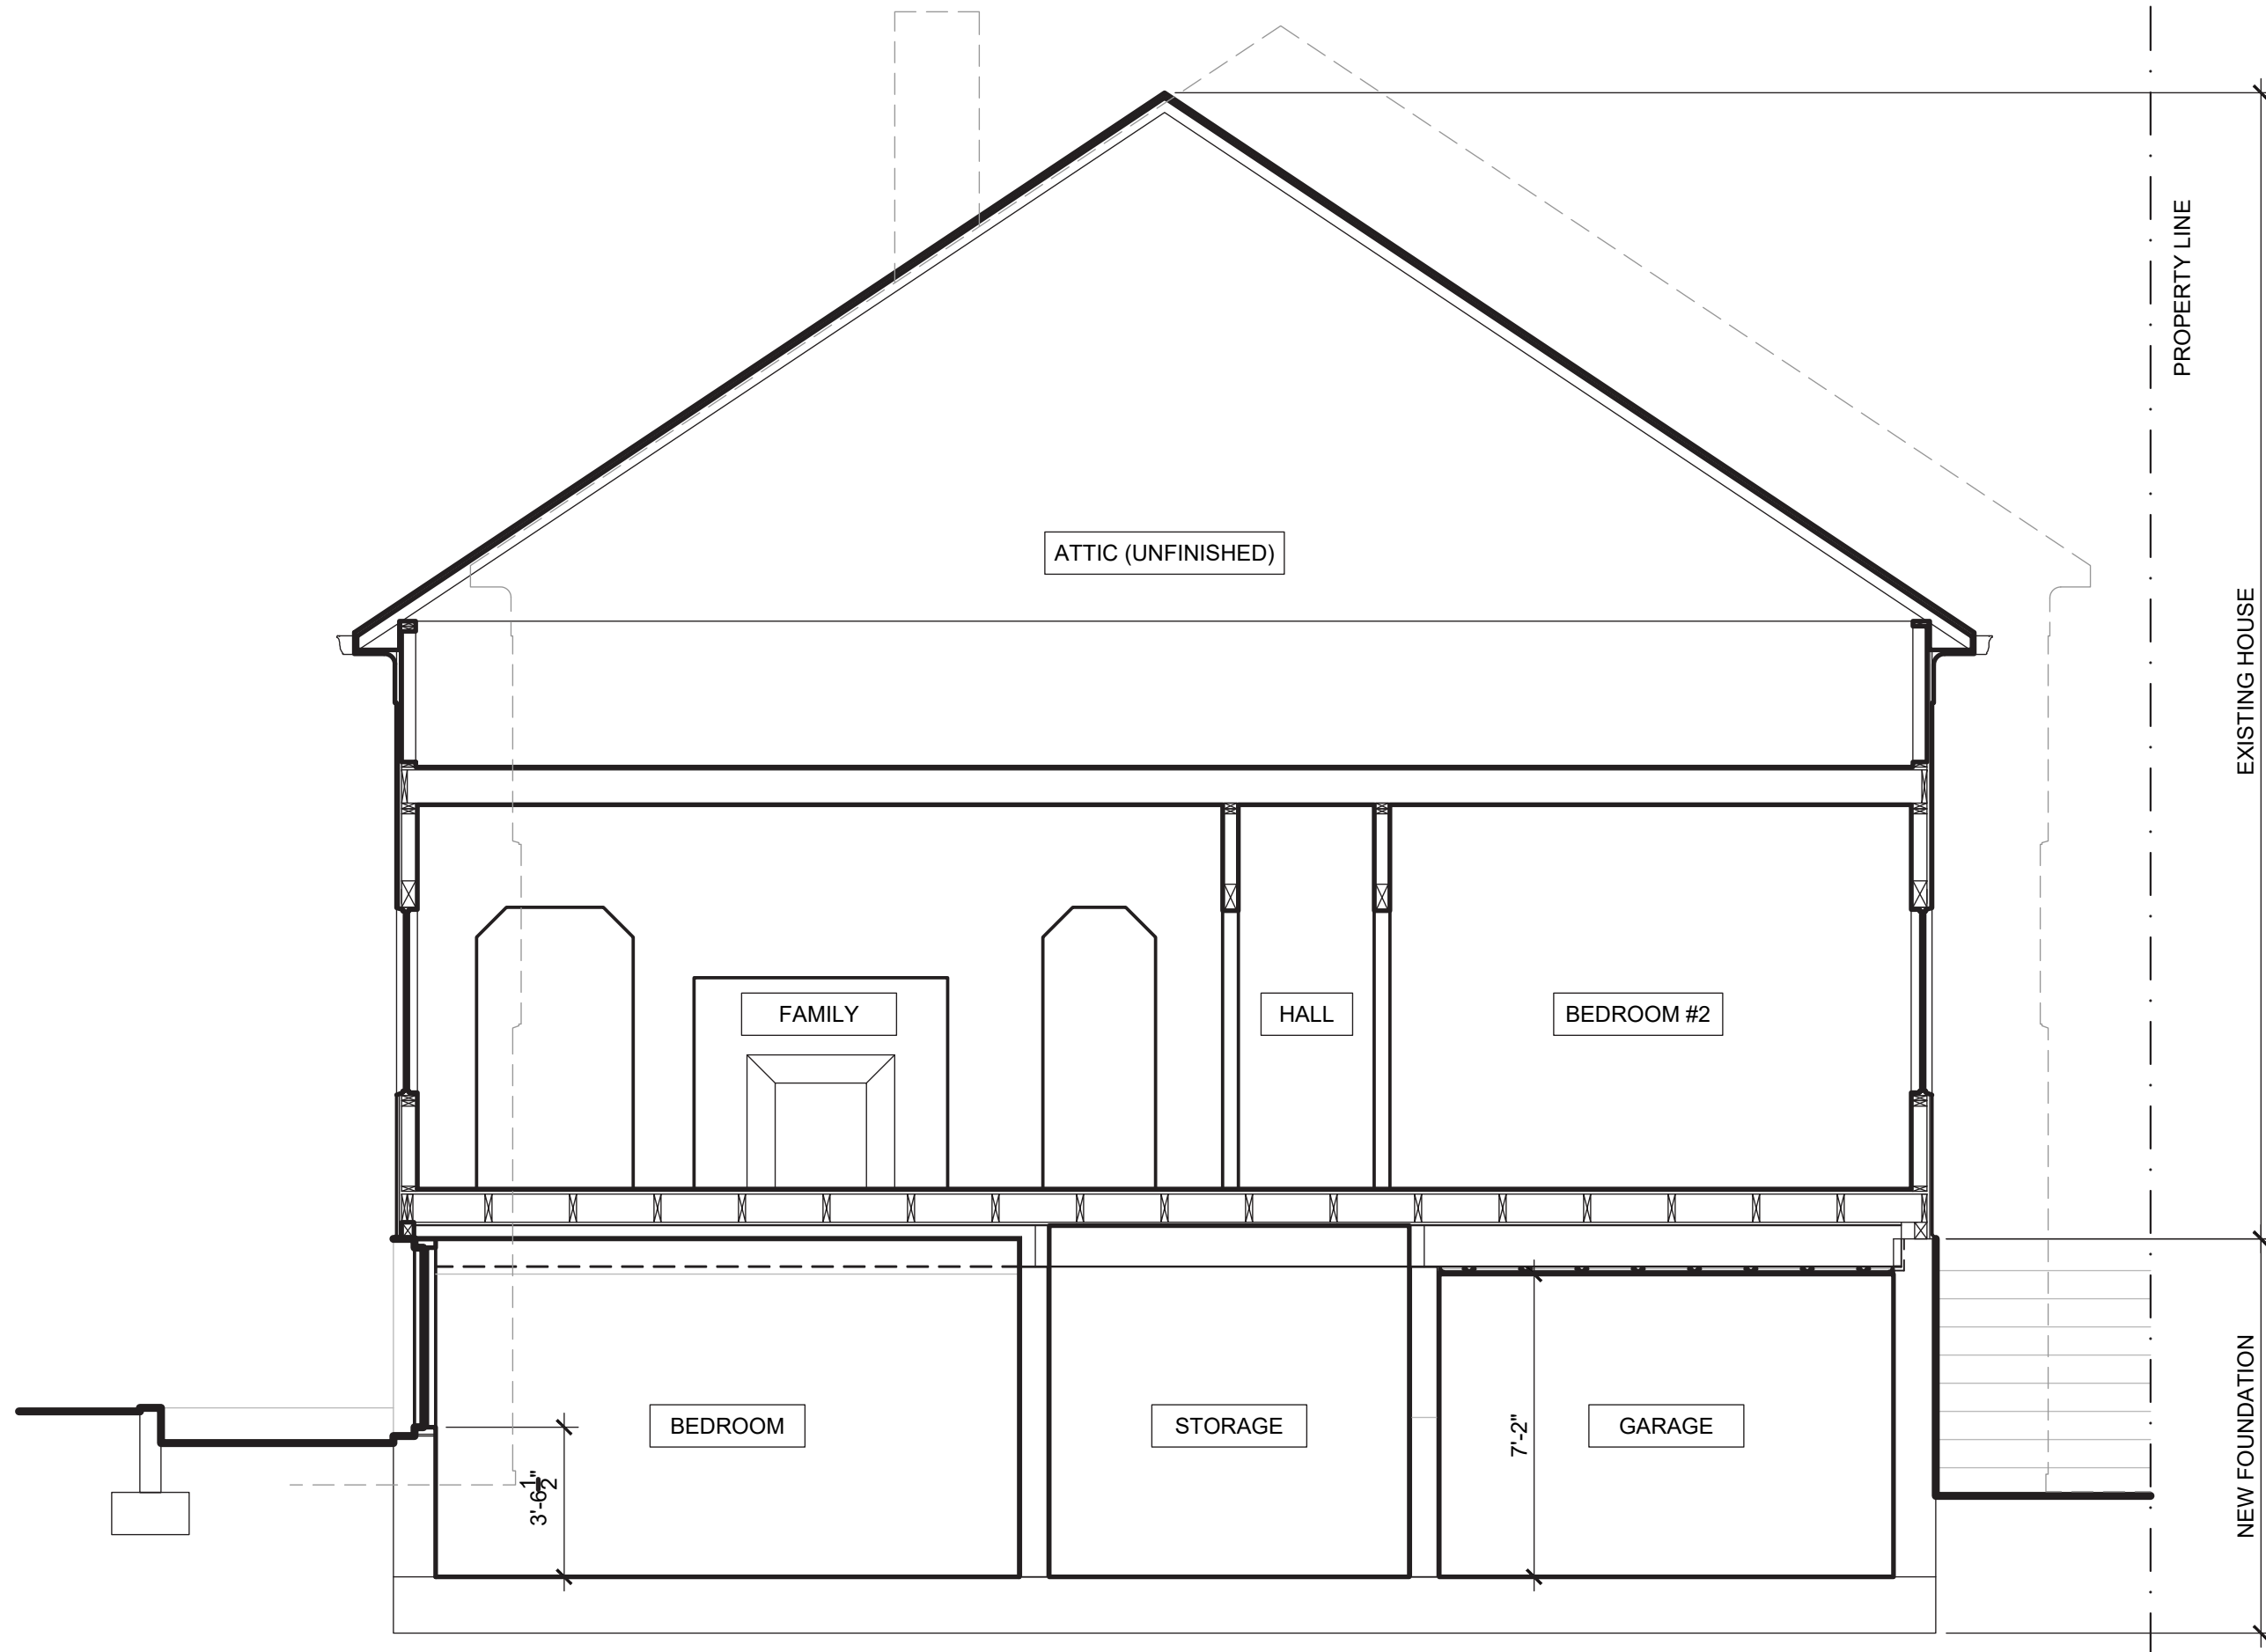


1 SECTION - PROPOSED CONDITION

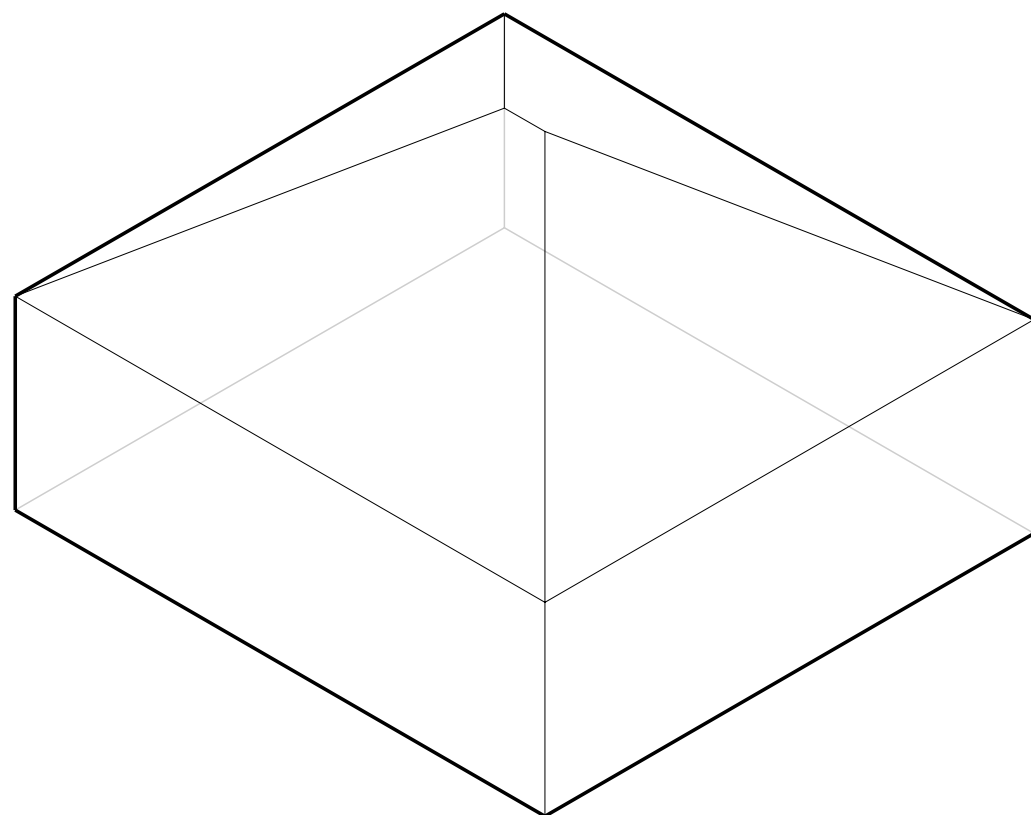


EXISTING HOUSE (LEVEL ONE AND ABOVE)

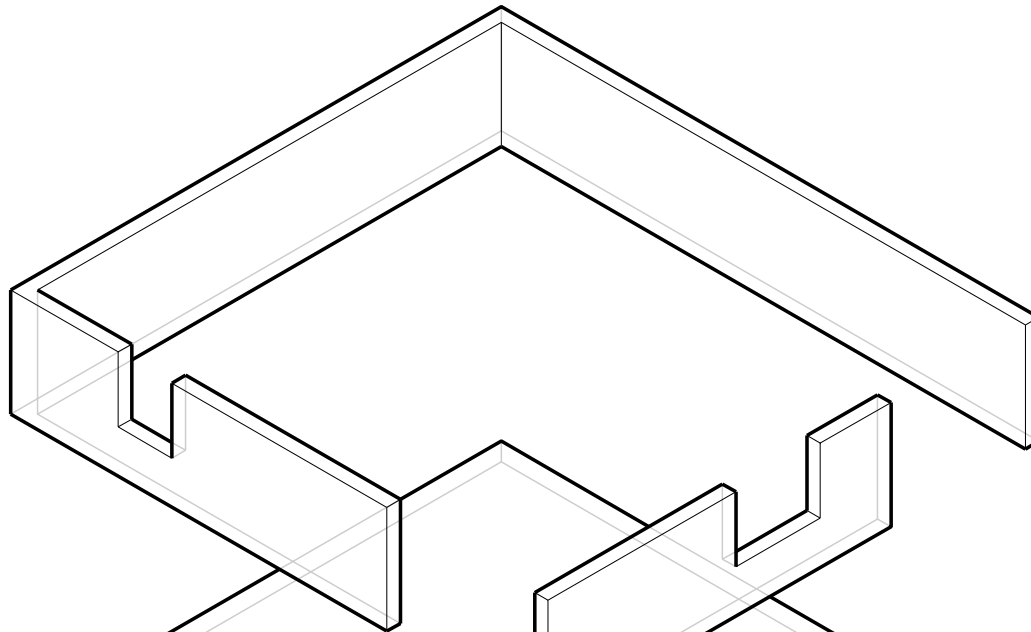

NEW CONCRETE FOUNDATION WALLS

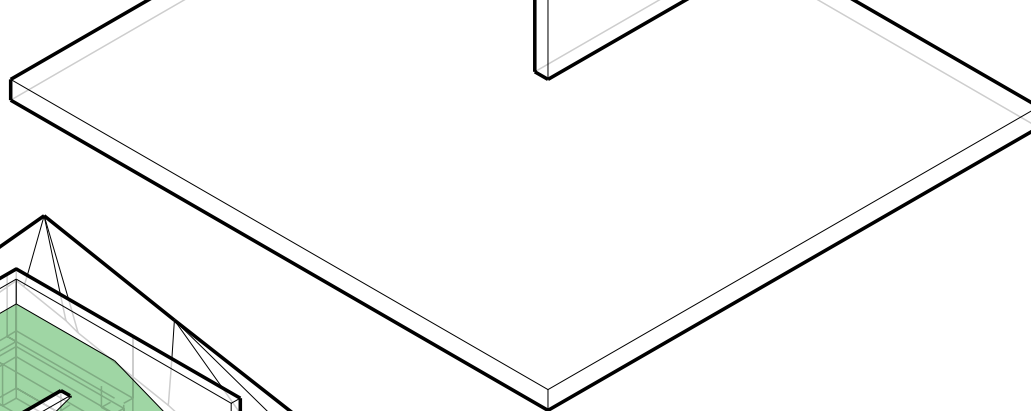

NEW CONCRETE MAT SLAB

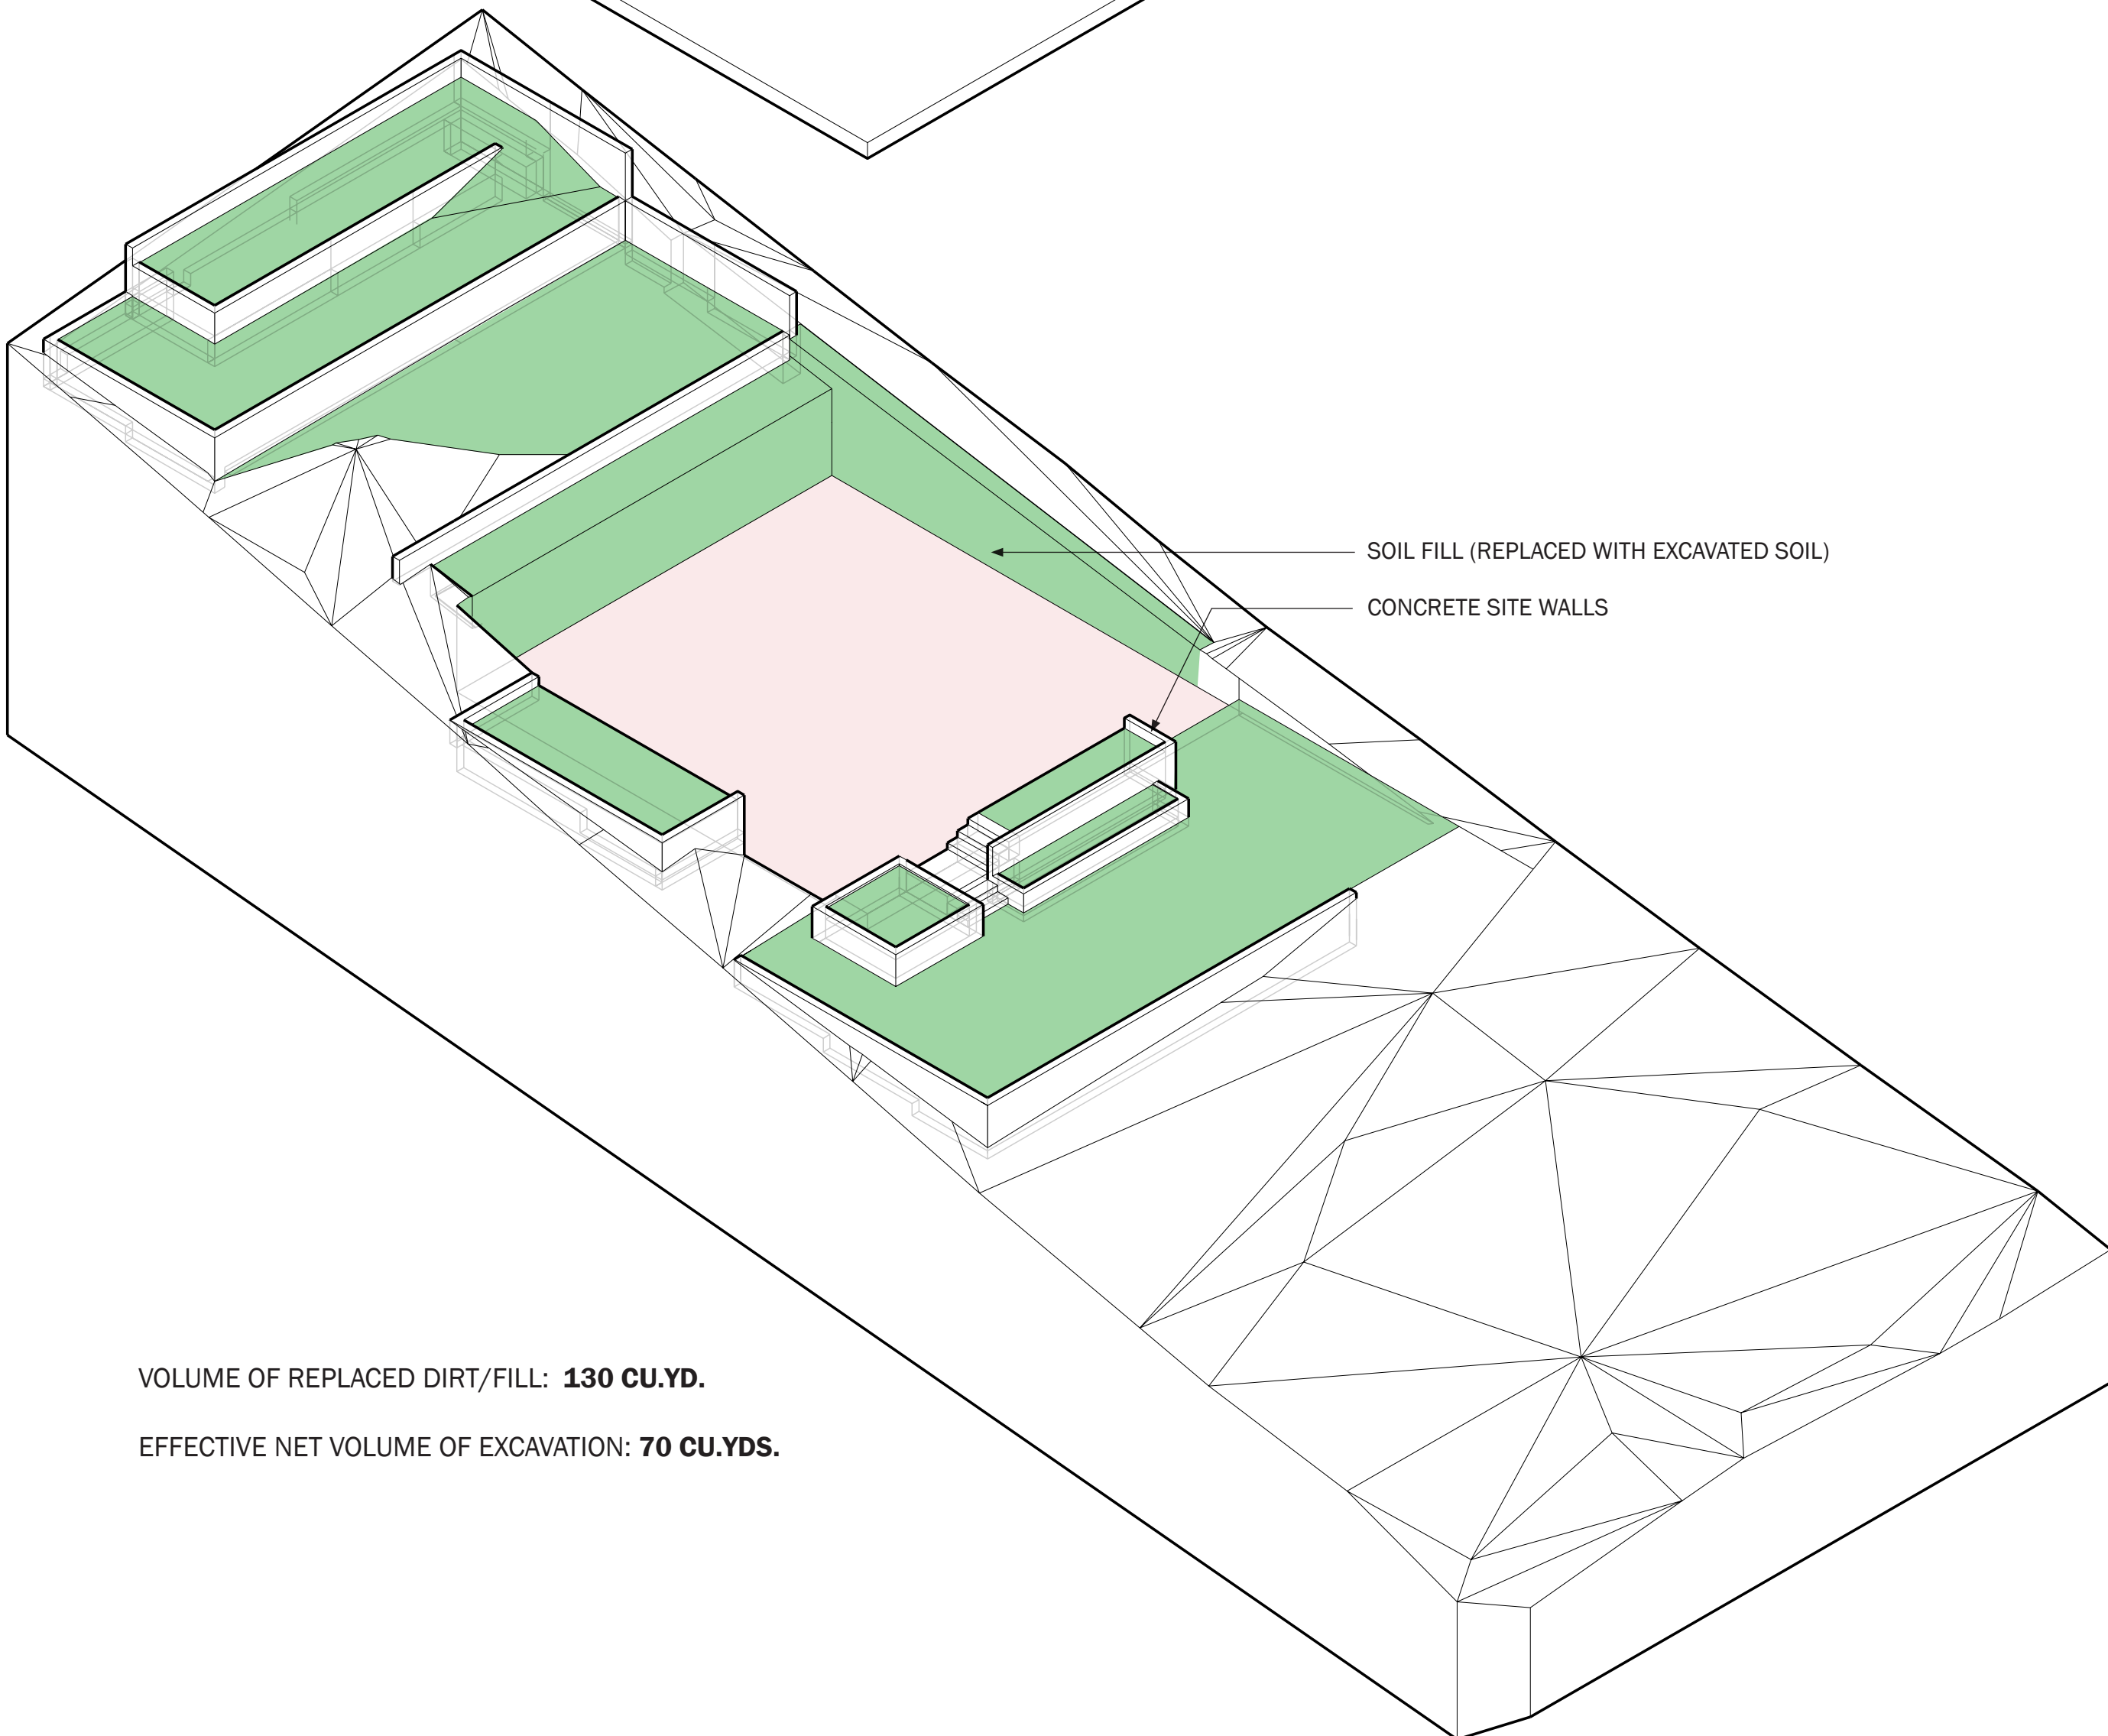


SOIL FILL (REPLACED WITH EXCAVATED SOIL)

CONCRETE SITE WALLS

VOLUME OF REPLACED DIRT/FILL: **130 CU.YD.**


EFFECTIVE NET VOLUME OF EXCAVATION: **70 CU.YDS.**

4 FINISHED SITE - REPLACED FILL

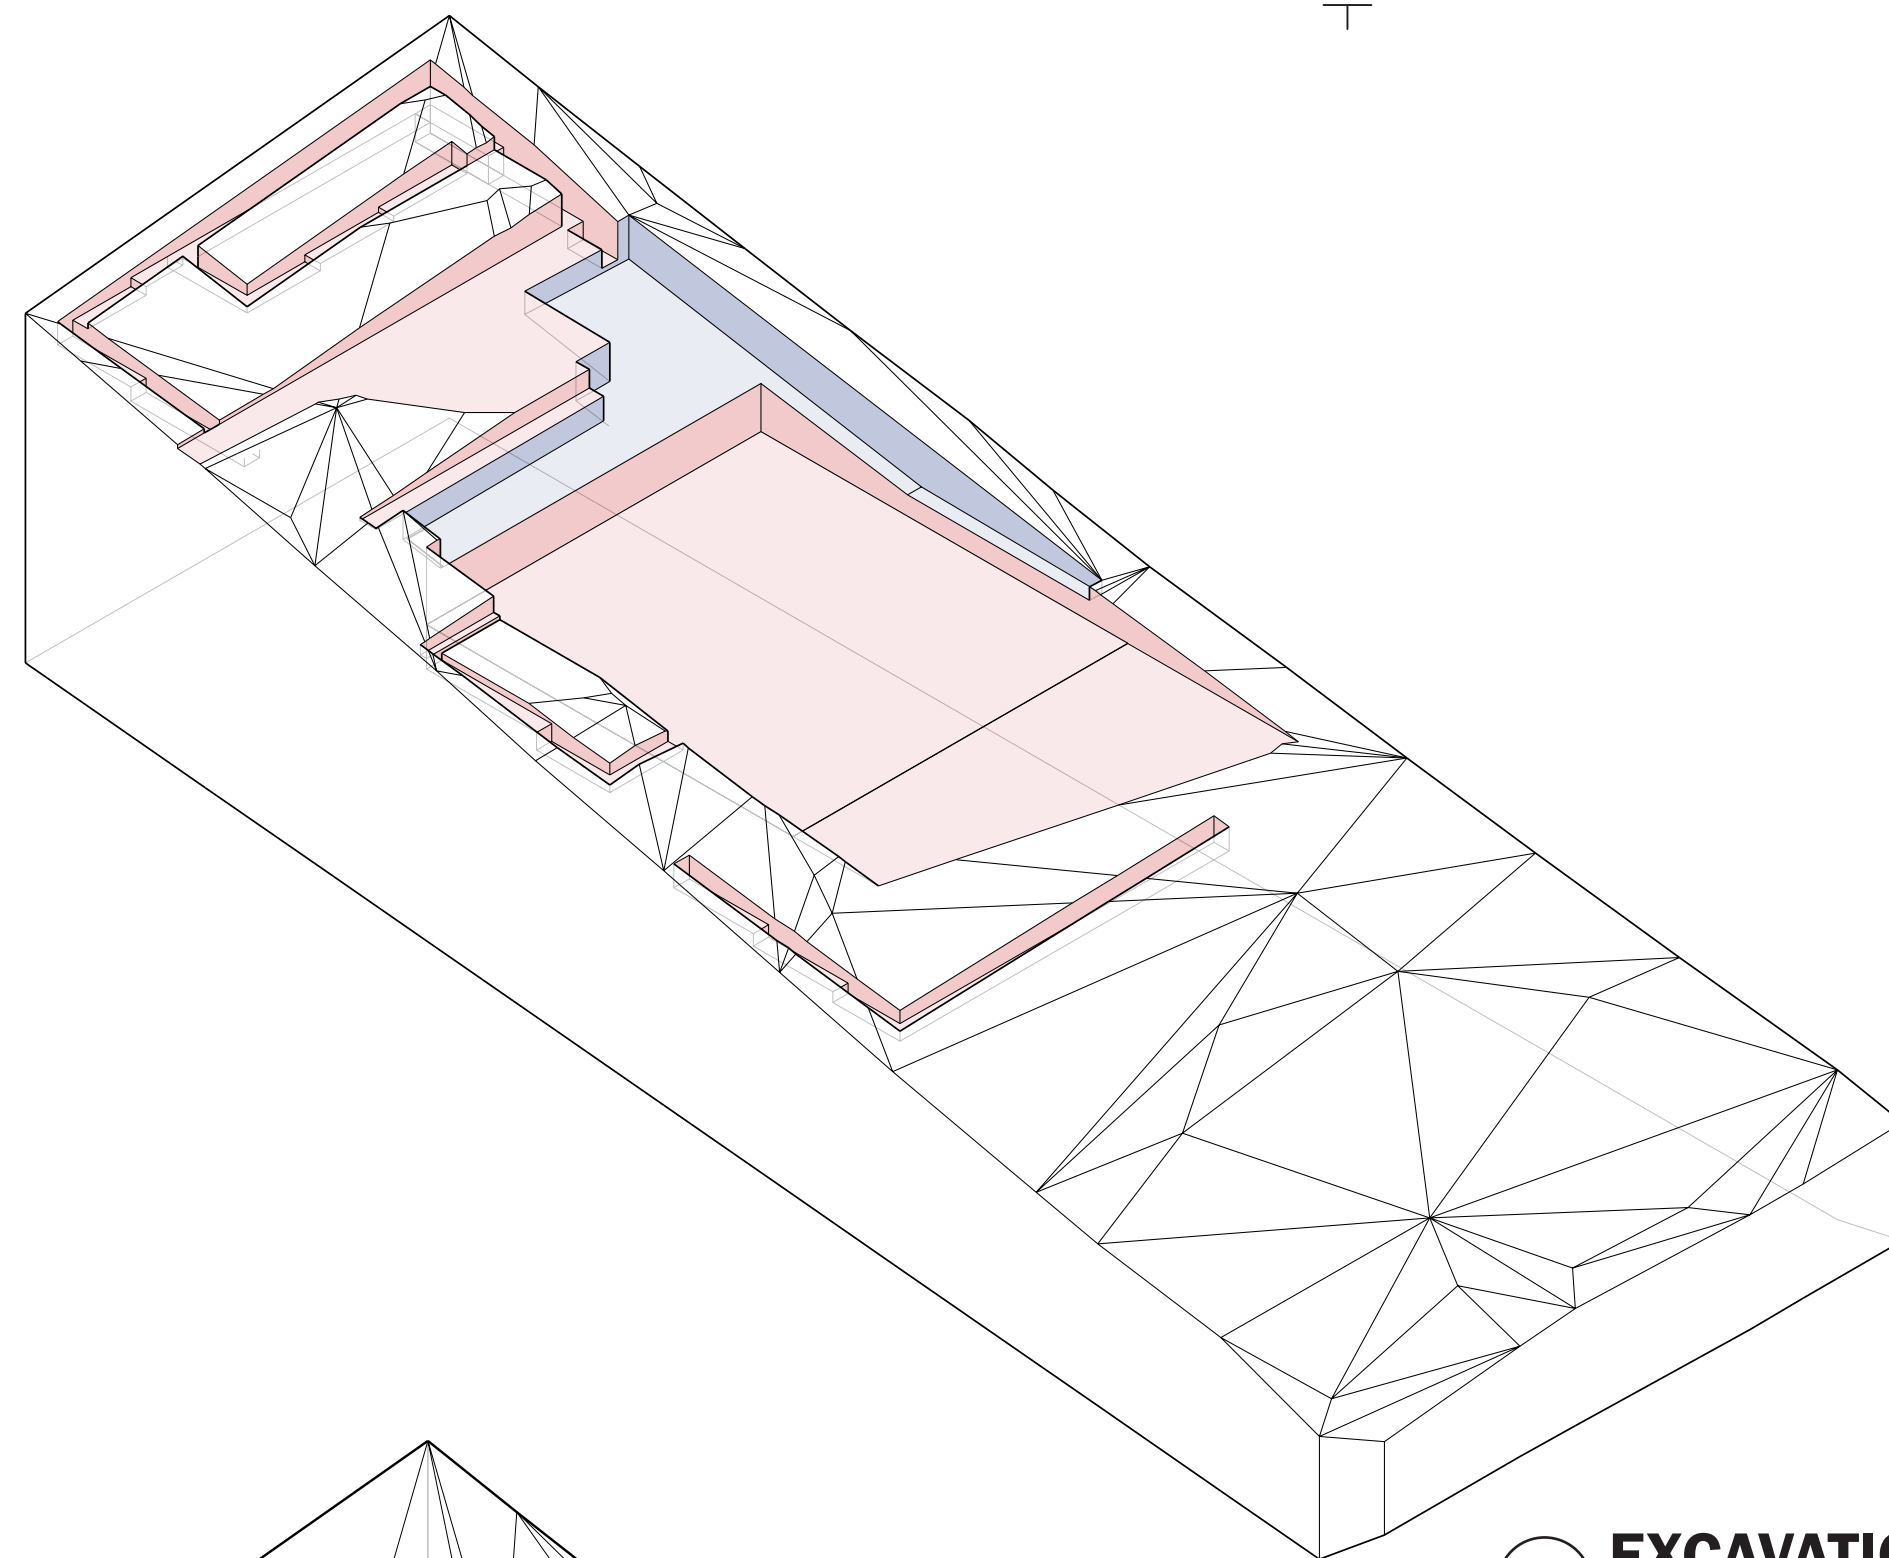


VOLUME OF EXCAVATED SOIL: **42 CU.YD.**
CUMULATIVE VOLUME: **200 CU.YD.**

3 EXCAVATION FOR SITE WALLS

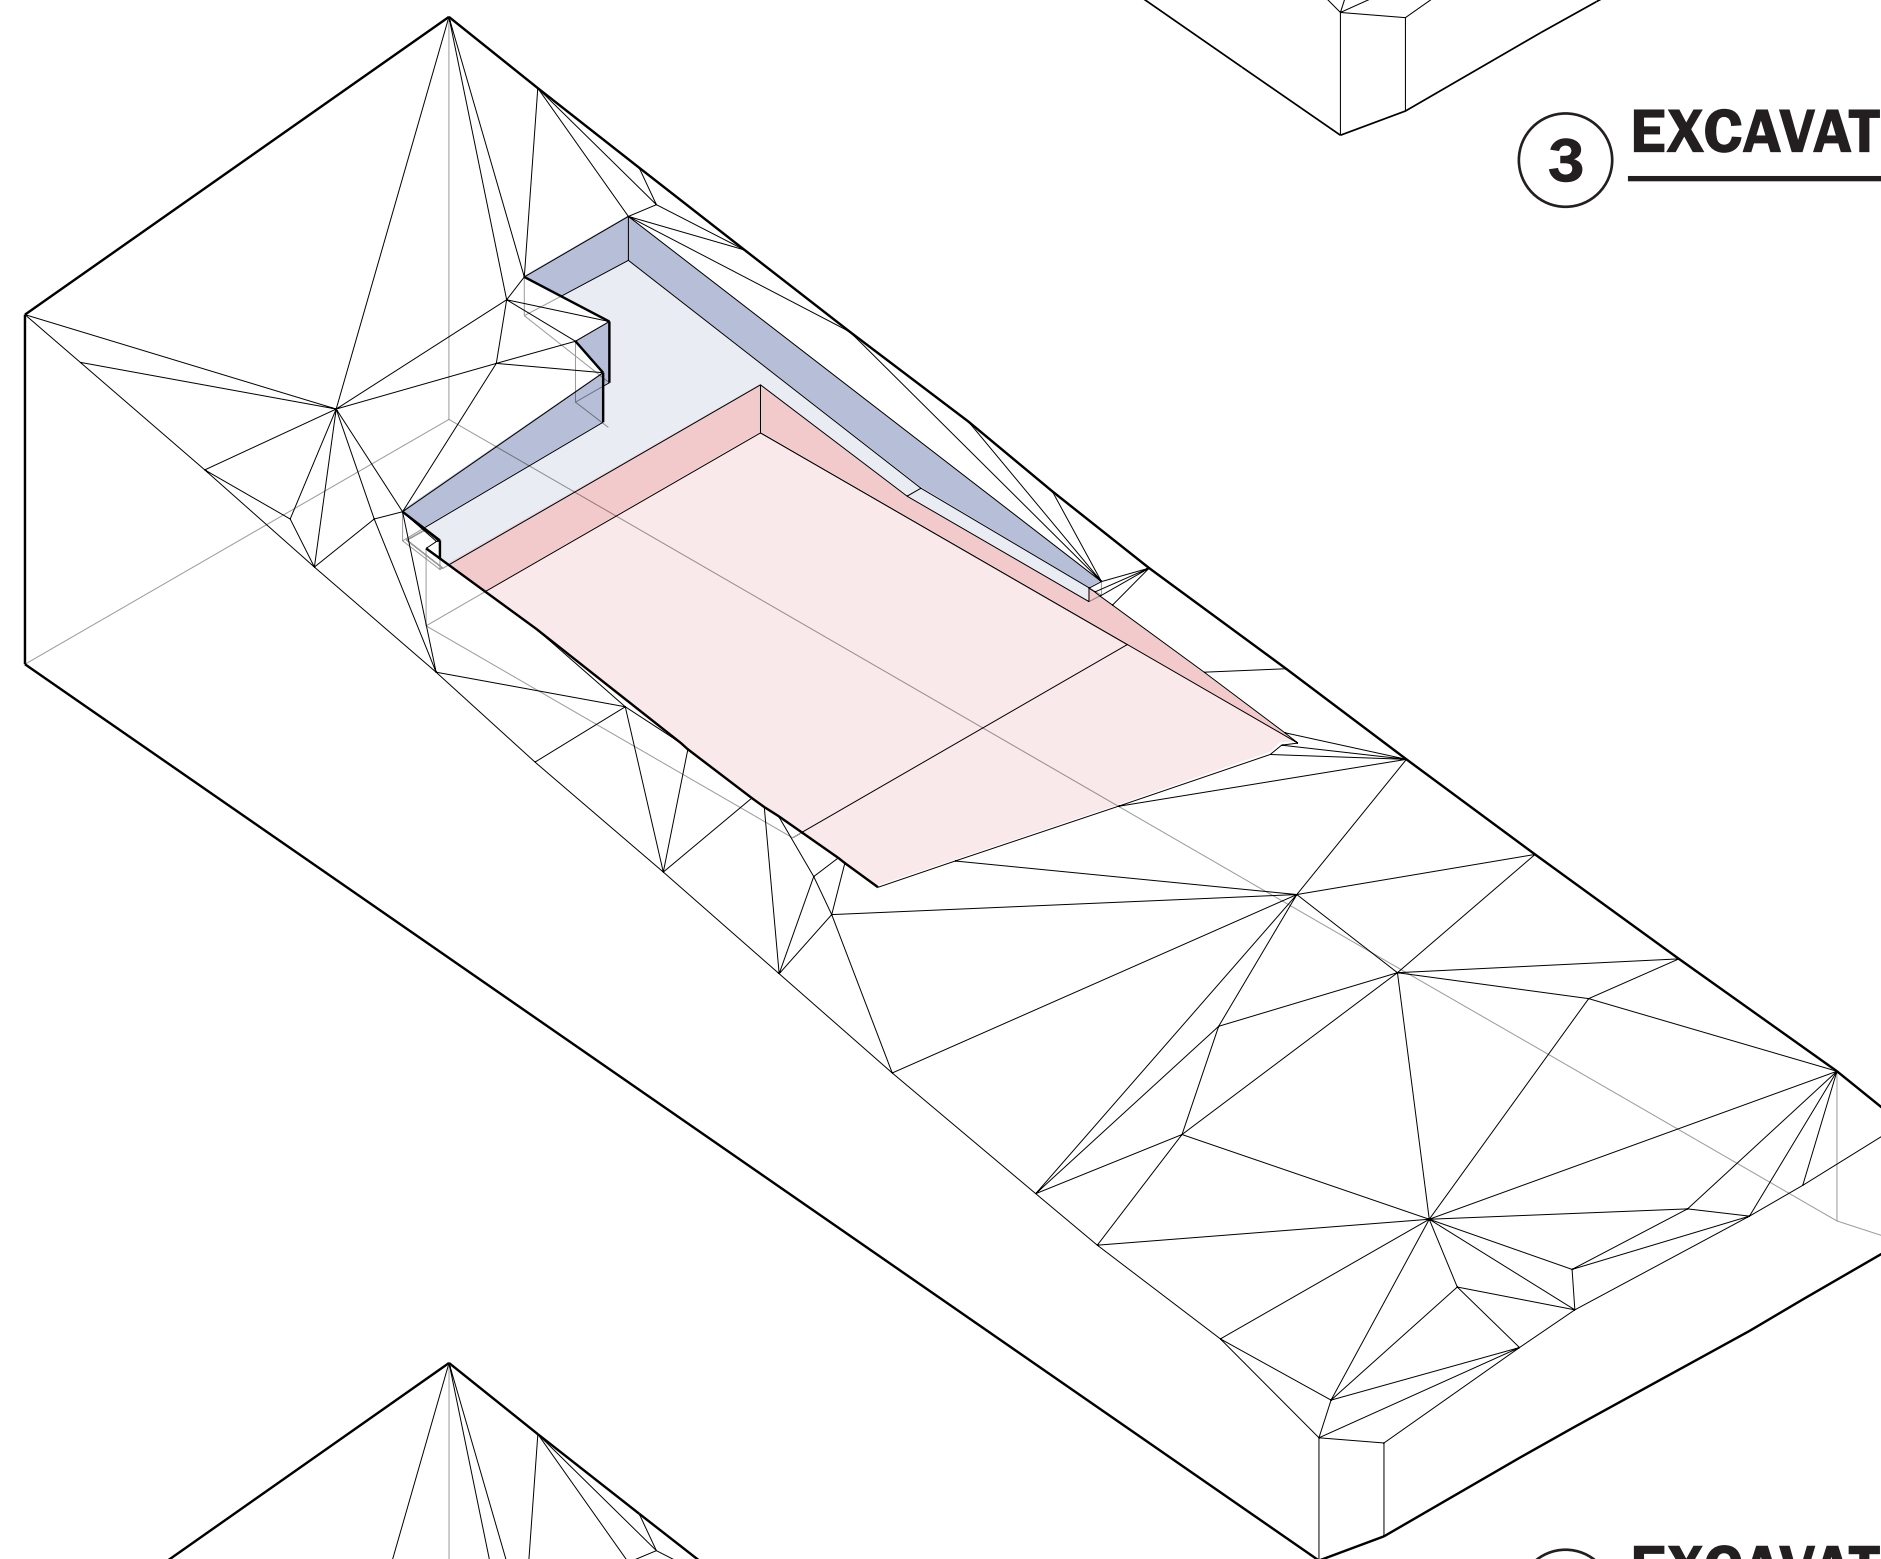

VOLUME OF EXCAVATED SOIL: **158 CU.YD.**

2 EXCAVATION FOR NEW FOUNDATION

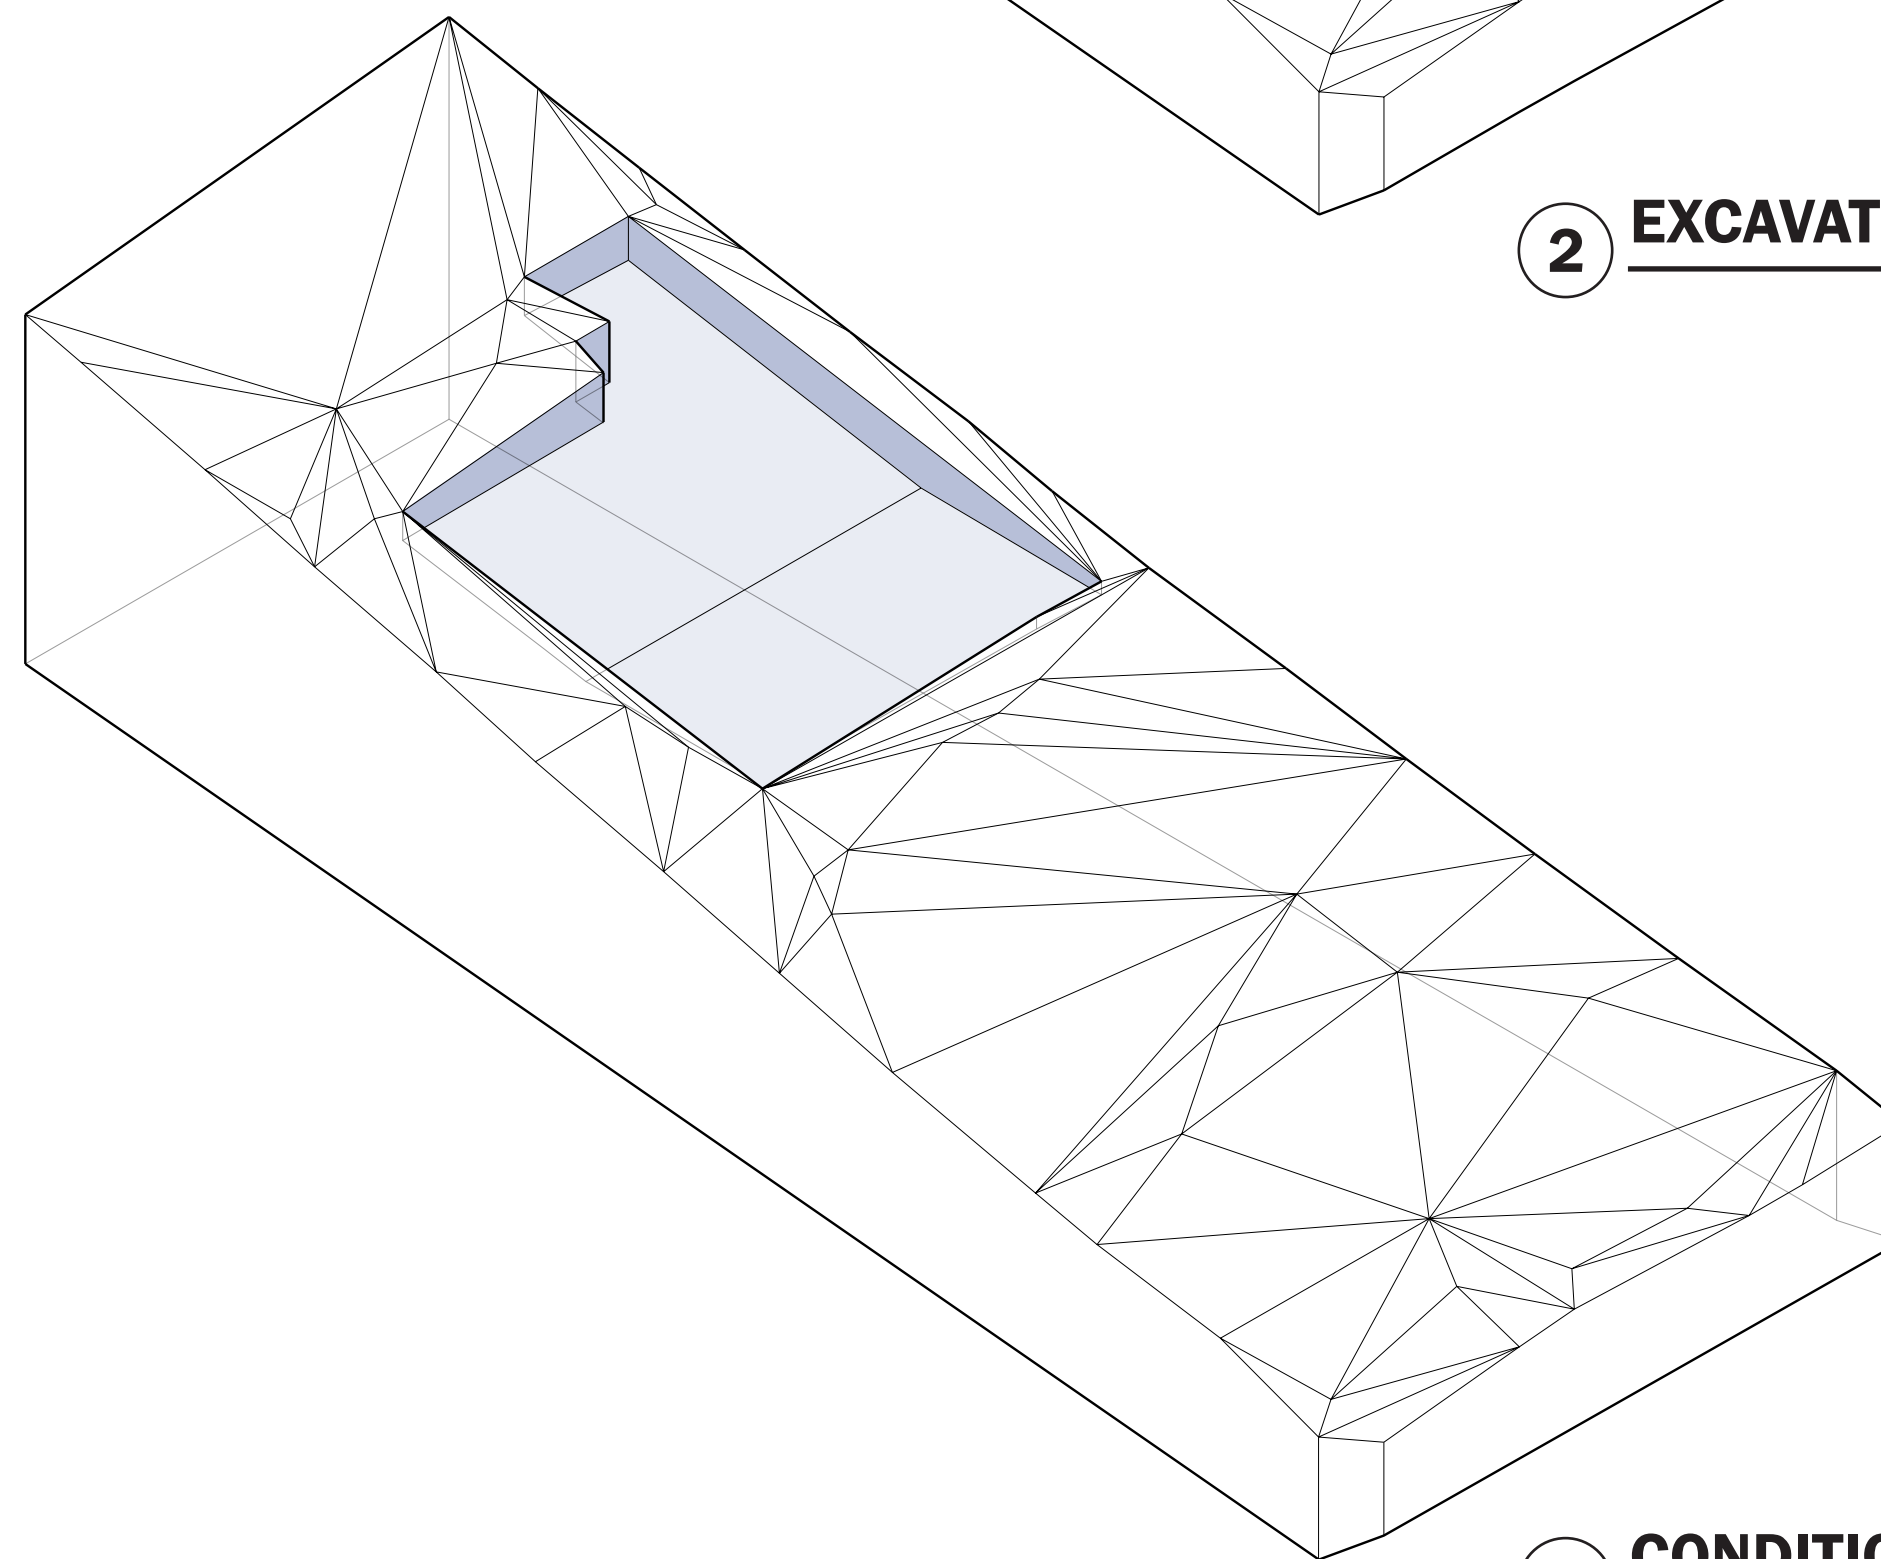

VOLUME OF EXCAVATION: **0 CU.YDS.**
(E) FOUNDATION REMOVED ONLY.

1 CONDITION @ FOUNDATION DEMOLITION